


T. 9S. R. 40E. W. M.

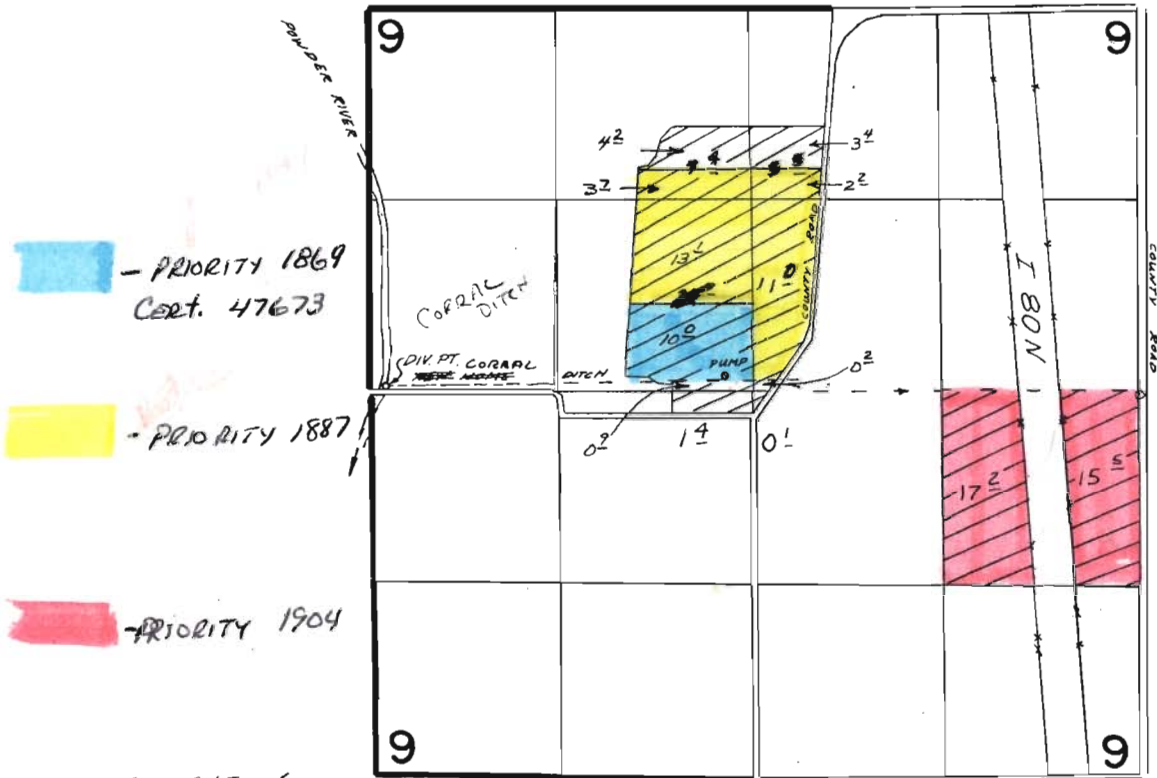

NO HIGHLIGHTING  
DOES NOT HAVE A RIGHT  
UNDER B-51

**FINAL PROOF SURVEY**  
UNDER

**TRANSFER B-51**

Application No. .... Permit No. ....  
IN NAME OF

..... **FRANK BAIRD** .....

Surveyed 5-23 1956 by M. BISH  
7-26 79 Y. CHURCH & O. JARRETT

*Subject to  
Change.*