


T.2N.R.32E.W.M.

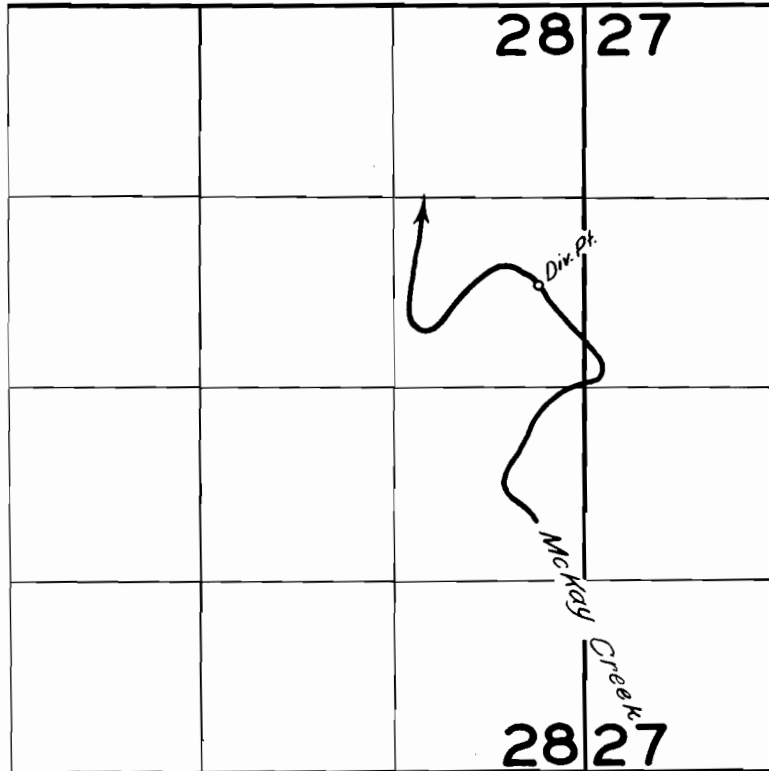

FINAL PROOF SURVEY
UNDER

TRANSFER No. B-87

IN NAME OF

HERMAN BEILKE

Surveyed *Sept. 20, 1961*, by *C. Bartels*