


T.5 S.R.13 E.W.M.

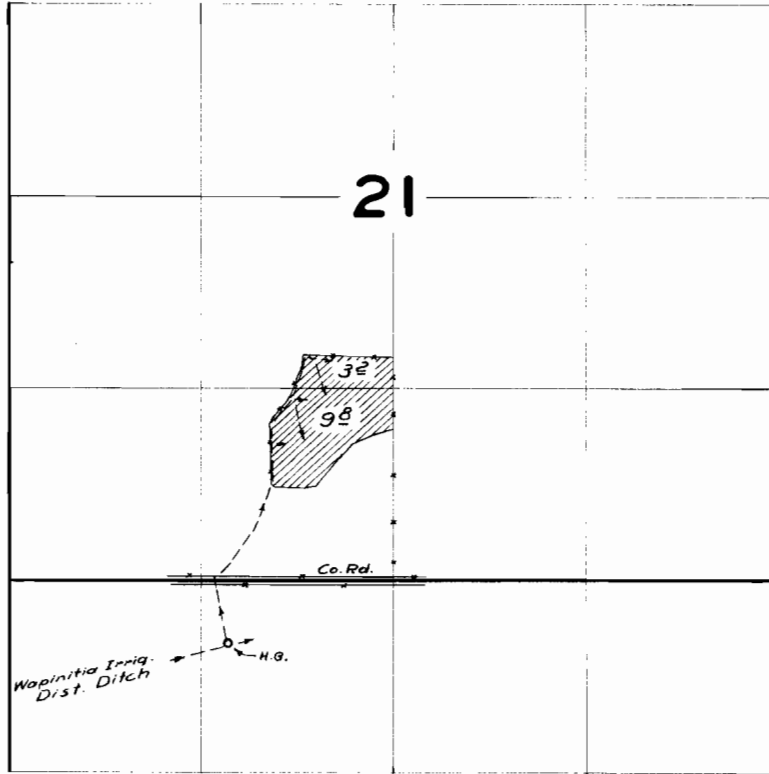

**FINAL PROOF SURVEY**  
UNDER

Transfer No. *B-98*  
Application No. \_\_\_\_\_ Permit No. \_\_\_\_\_  
IN NAME OF

..... *H. G. HAMMER* .....

Surveyed *Nov. 9* 1959, by *M. Bish*