


T.5 S.R.13 E.W.M.

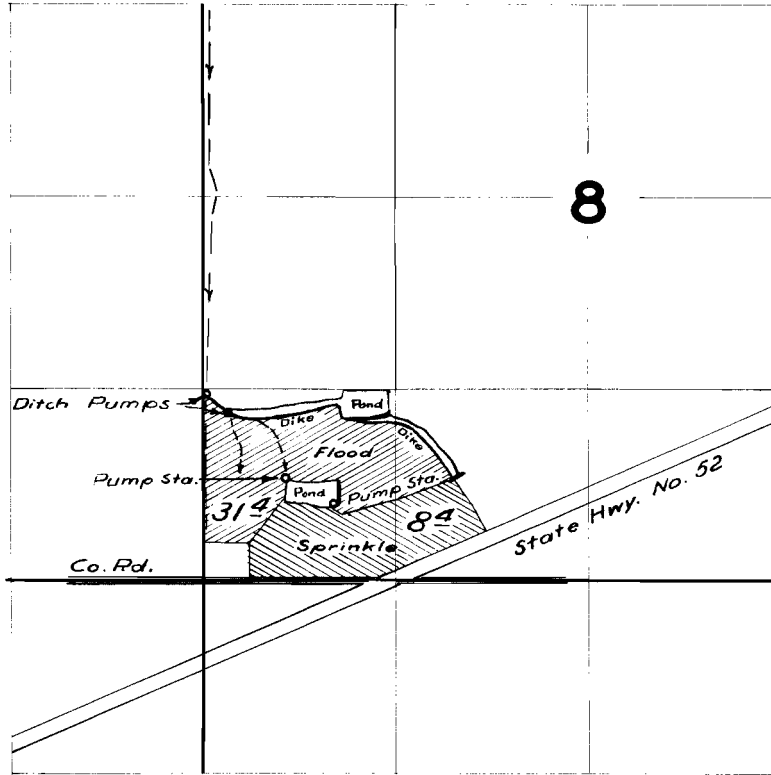

FINAL PROOF SURVEY UNDER

Transfer No. B-99

Application No. Permit No.

IN NAME OF

..... FLOYD KELLY

Surveyed 17 Nov 1959, by *T. Bish*