


B-89

Stone E 1/4 Cor. Sec. 36
T.13 S. R.41 E.

WE Hillspie
Dec 14, 1955

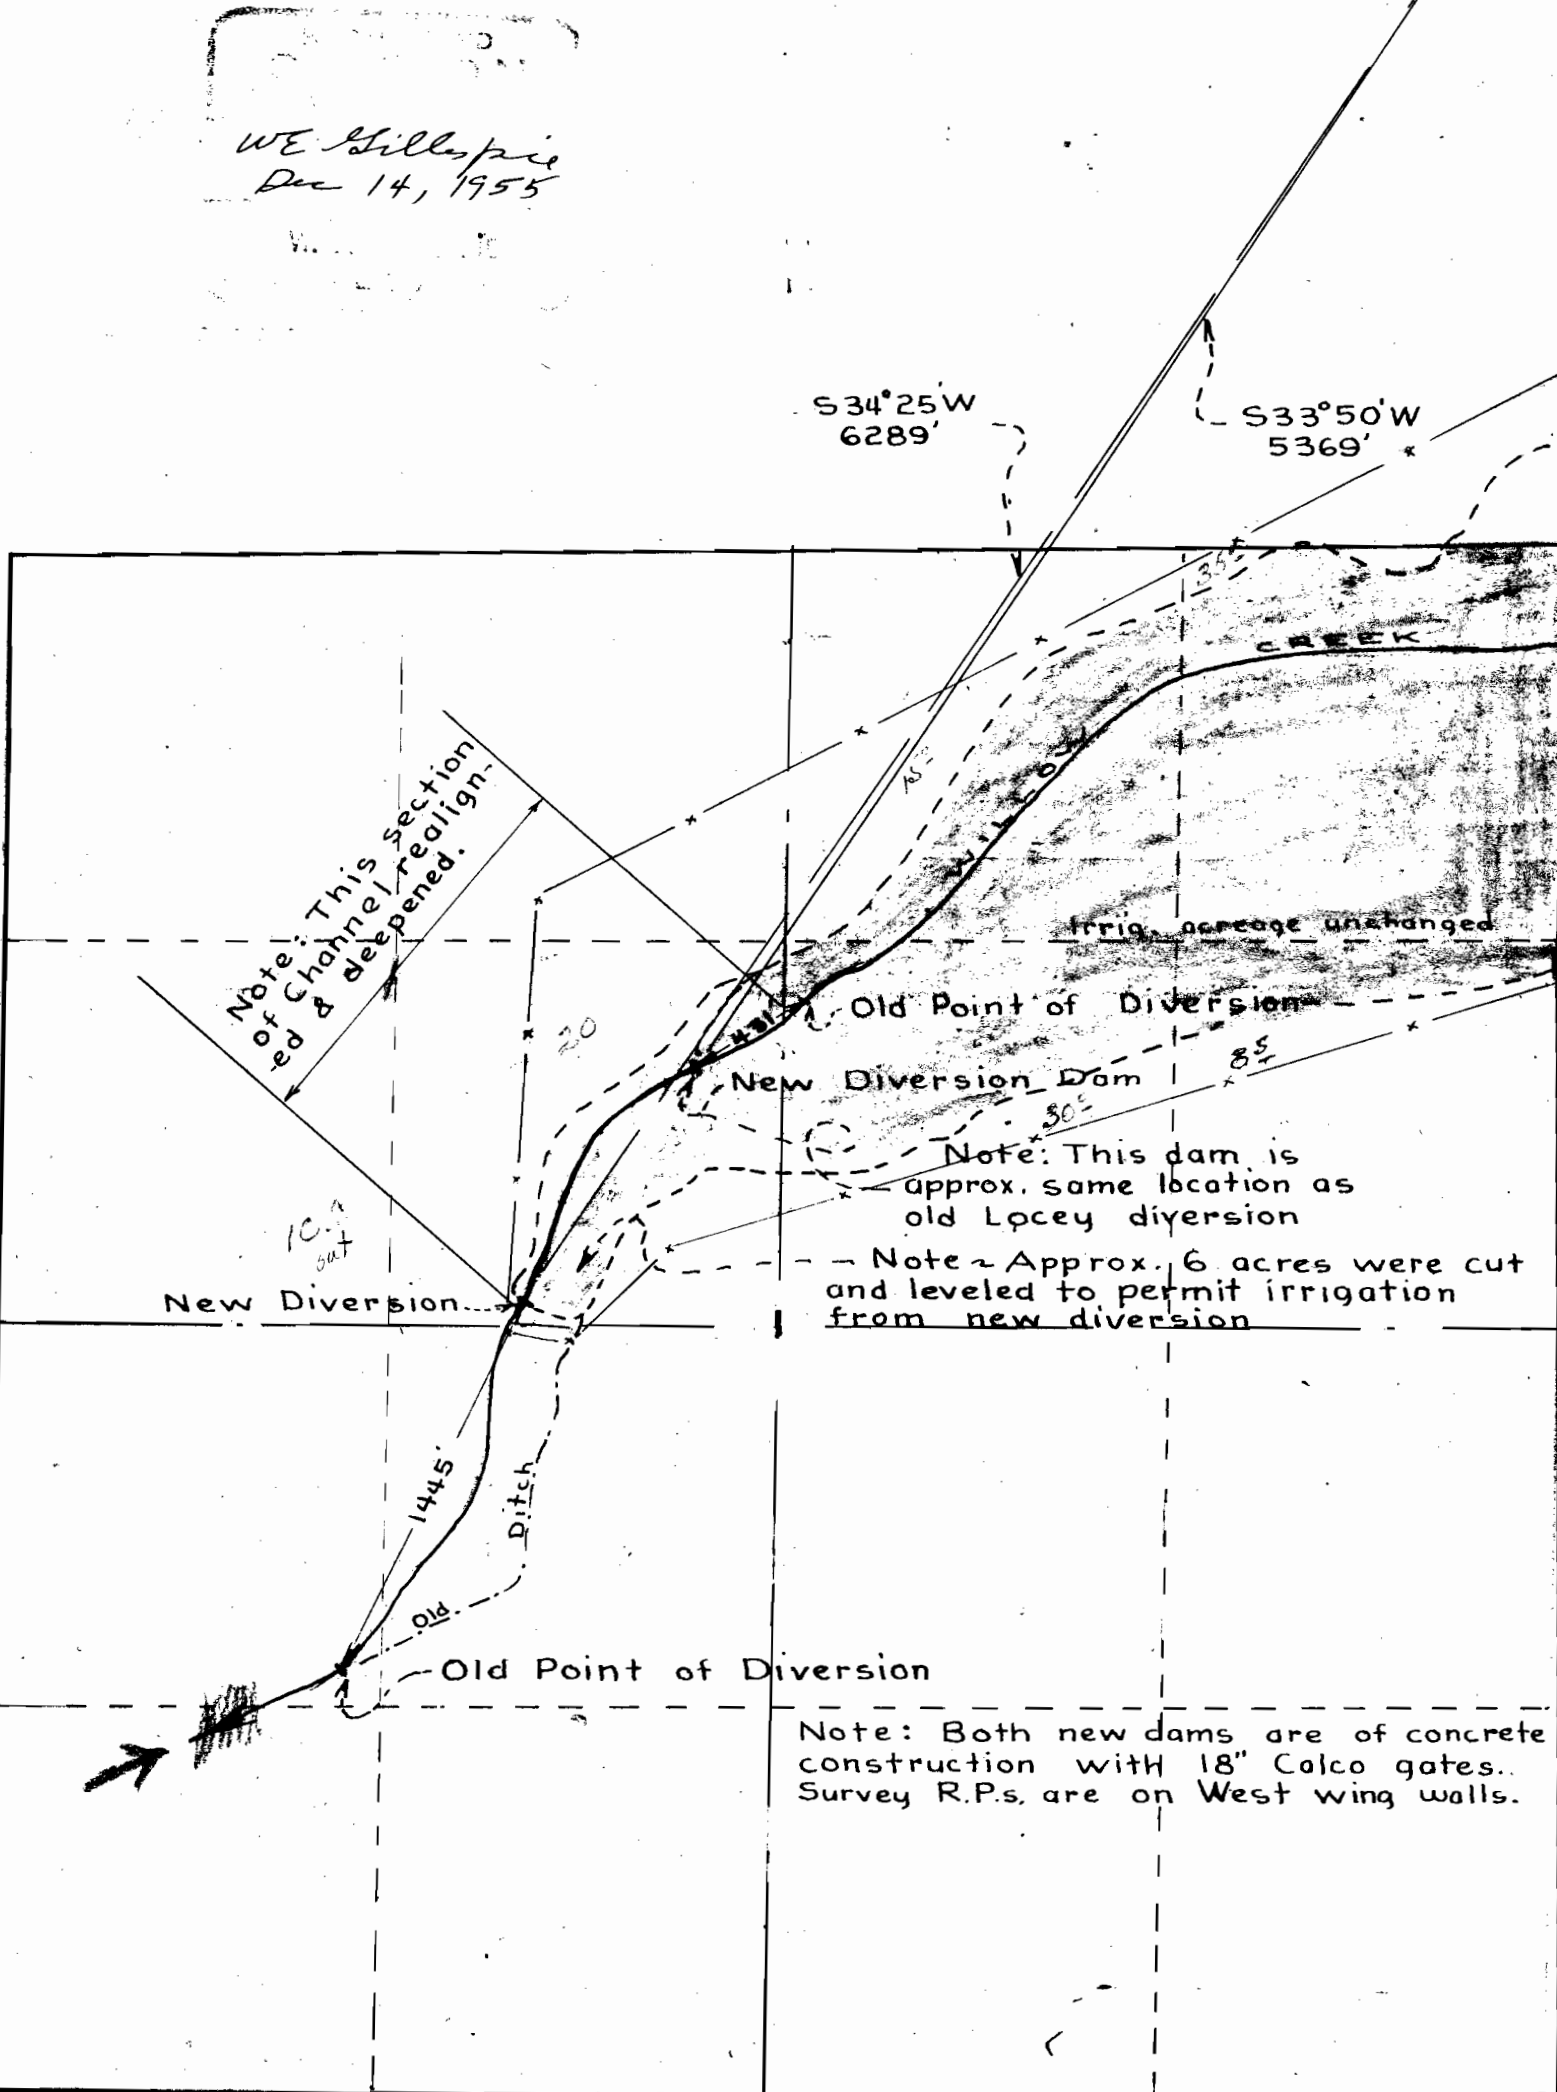

SEC. 1, T.14S. R.40E.
CHANGE OF POINT OF DIVERSION
Rosina Bronson-Ironside, Ore.