


T. 38 S., R. 4 W., W.M.

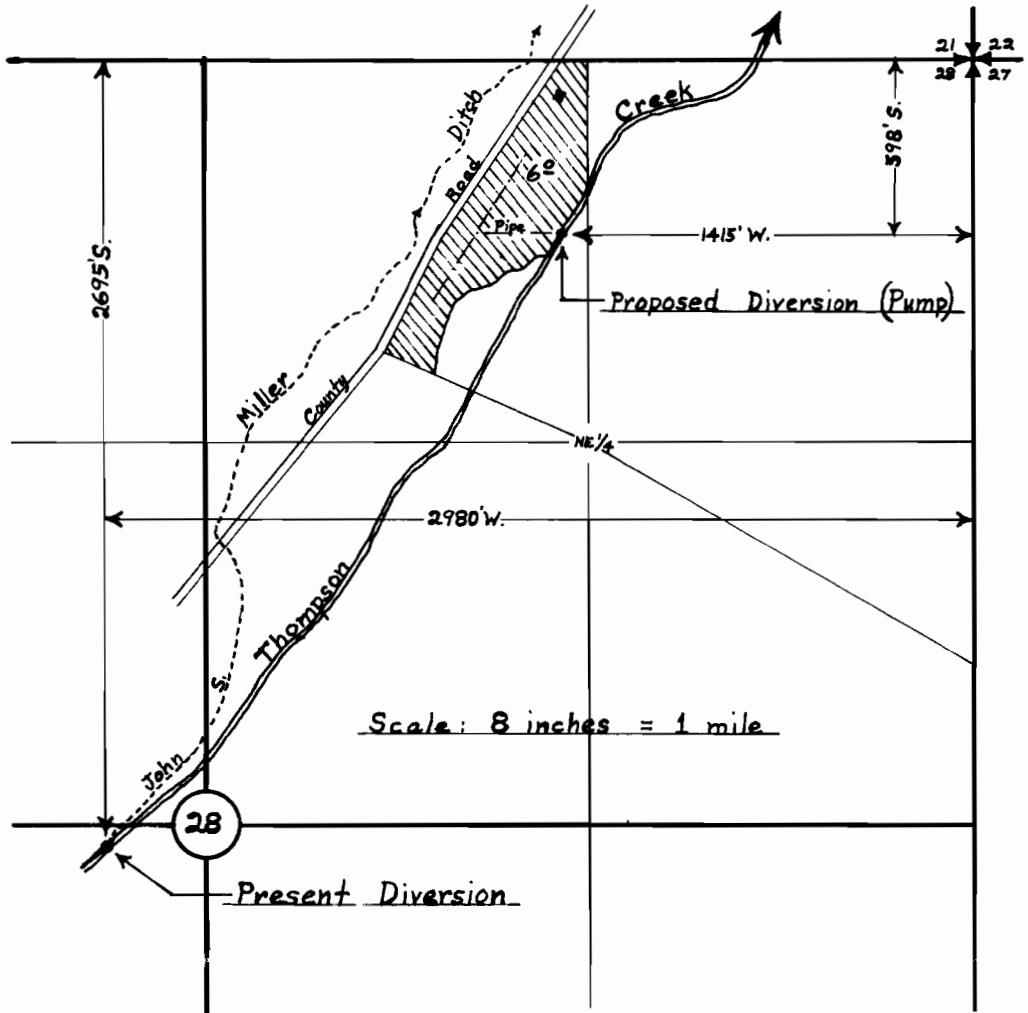

Map to accompany application in the name of Lloyd W. Burks, for a change in point of diversion of water from Thompson Creek.

This Office --- October 28, 1958.

David C. Hendrix, Watermaster Dist. #15.

10 101