


T.38S.R.8W.W.M.

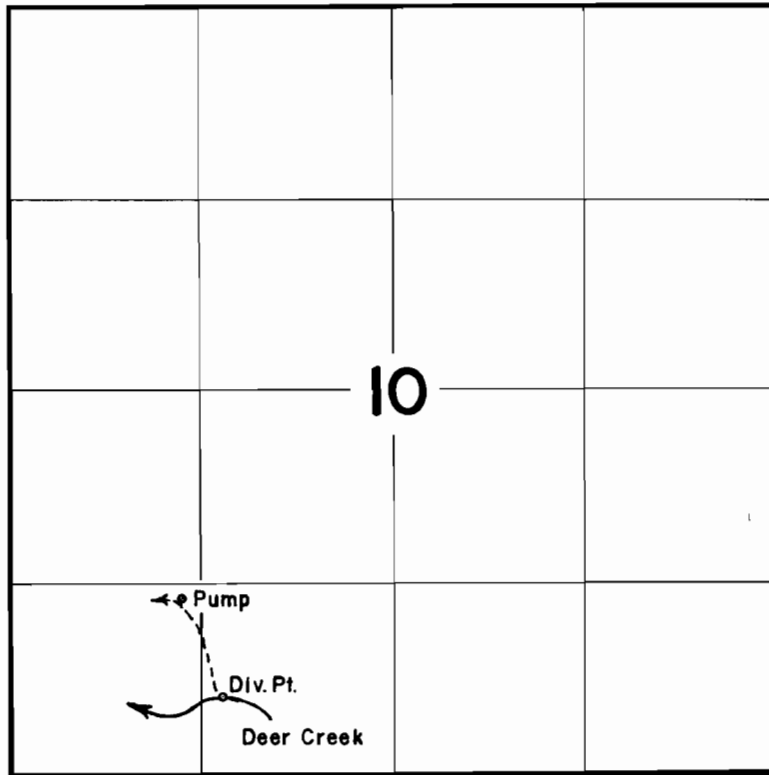

**FINAL PROOF SURVEY**  
UNDER

Transfer No. B-113  
Application No. .... Permit No. ....  
IN NAME OF

**Benson J. Benjamin**

Surveyed April 17, 1961, by C.O. Bartels