


T.7S. R.6W.W.M.

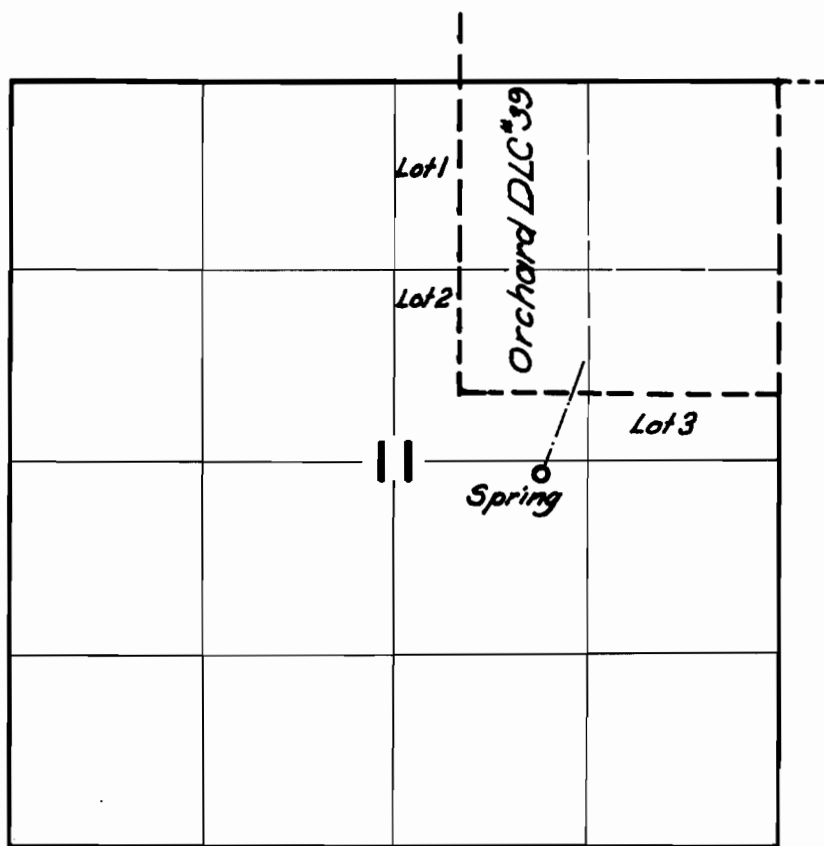

FINAL PROOF SURVEY
UNDER

Transfer B-115

Application No. _____ Permit No. _____
IN NAME OF

Harry E. Brown

Surveyed *27 Aug.* 1962, by *Carl R. Baker*