


T.14S. R.13E. W.M.

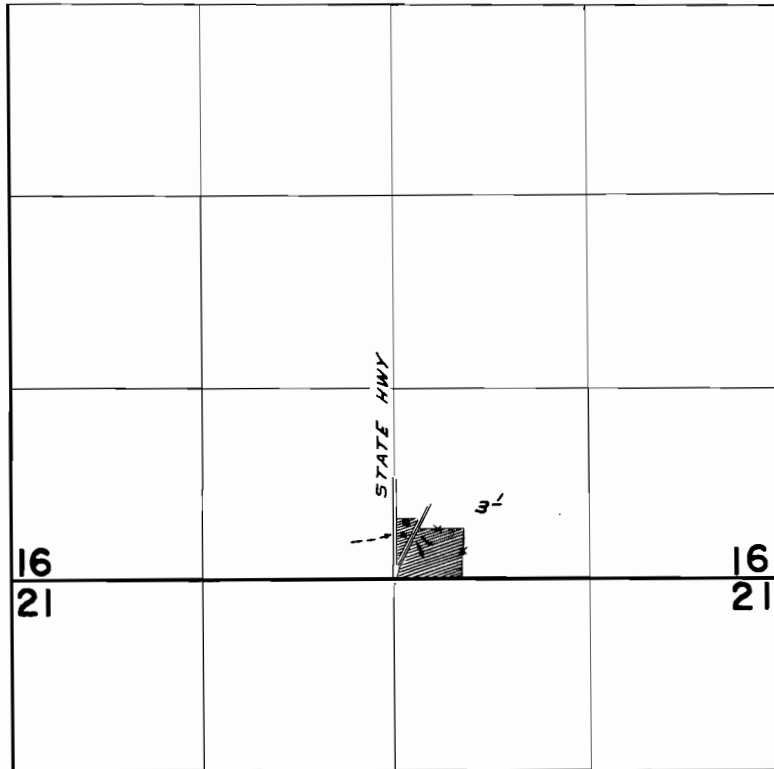

FINAL PROOF SURVEY
UNDER

TRANSFER B-128

Application No. Permit No.
IN NAME OF

..... J. E. BOOTH

Surveyed AUG. 19...., by C. GARDNER