


T.17S. R.12E. W.M.

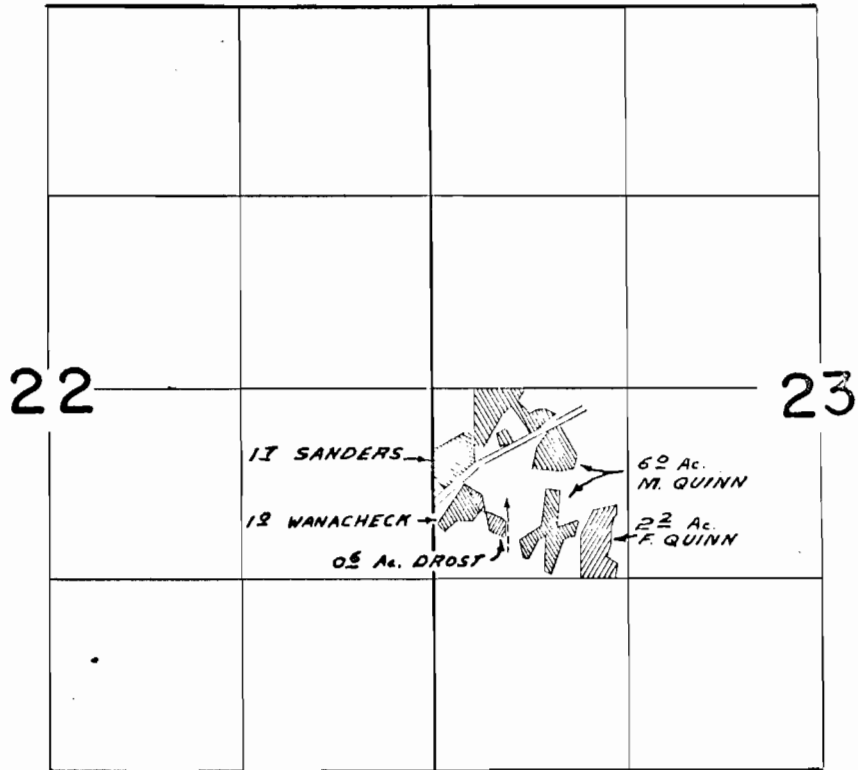

**FINAL PROOF SURVEY**  
UNDER

TRANSFERS B-130 & H-152  
Application No. .... Permit No. ....  
IN NAME OF

.....  
Surveyed May 5, 1966, by W.O. Ruppert