


T.38S.R.3E.W.M.

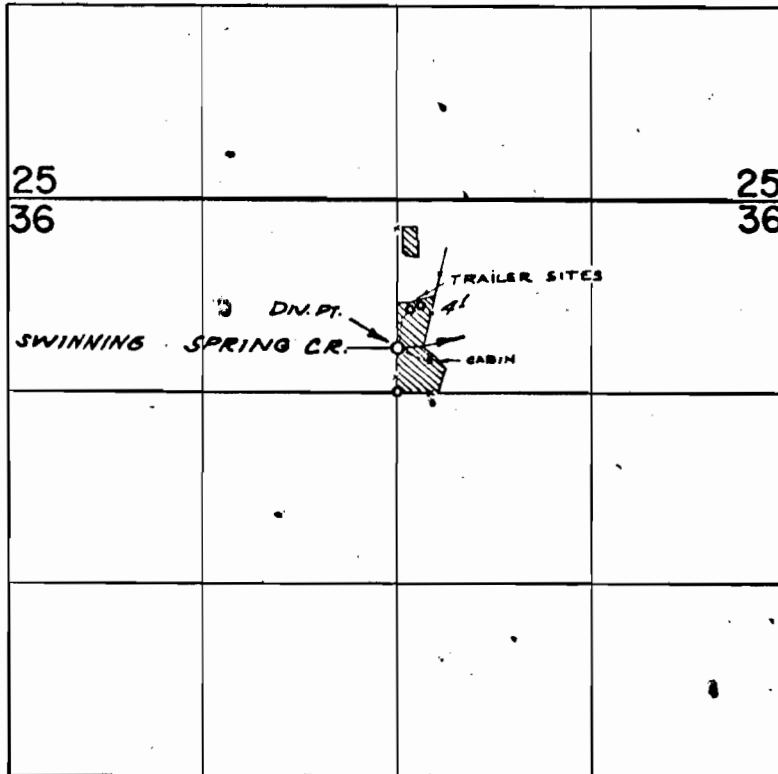

DIV. PT. LOC: 300' N. 6' 10" E. FROM SW. COR. NW 1/4 NE 1/4 SEC. 36

FINAL PROOF SURVEY UNDER

Transfer B-135

Application No. *38693*..... Permit No. *28786*.....
IN NAME OF

.....*MARK E. & JOAN N. BOYDEN*.....

Surveyed *OCT. 20, 1971*., by *R. MUCKEN*