


T.37S. R.6 W.W.M.

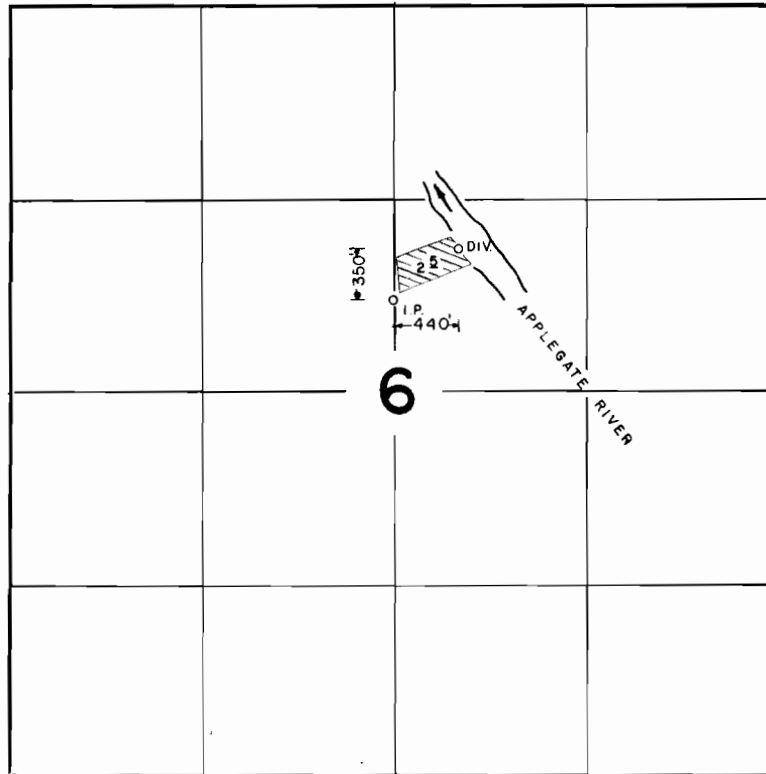

FINAL PROOF SURVEY
UNDER

TRANSFER
Application No. B-149 Permit No.
IN NAME OF

FRED E. & L.M. BAUGH

Surveyed March 22 1966, by R.B. STEIMER