


T. 13 S. R. 5 W. W. M. .

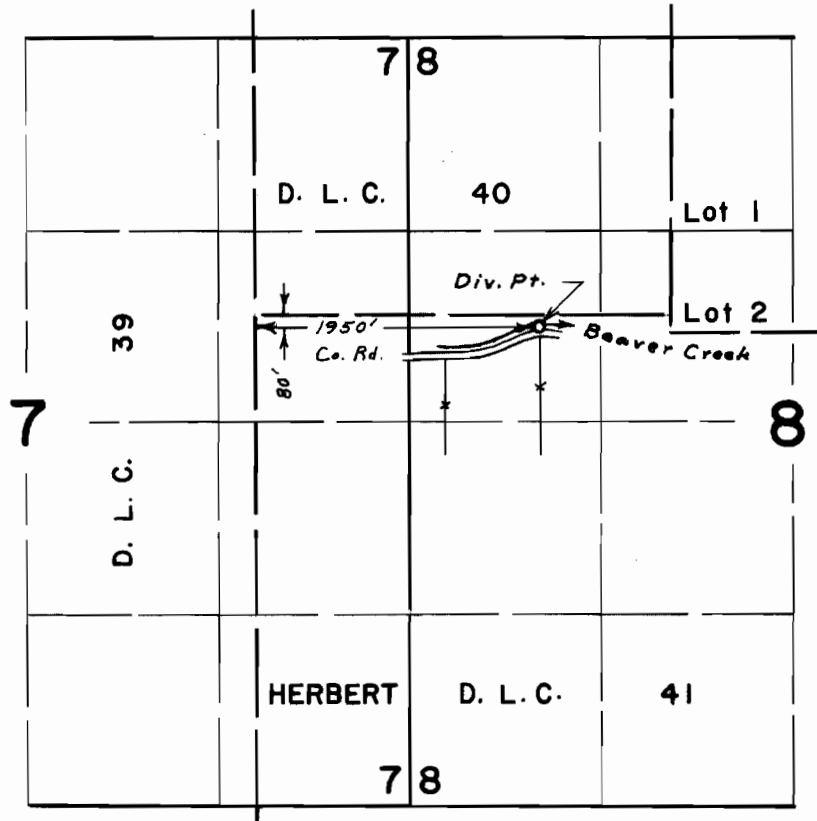

FINAL PROOF SURVEY
UNDER

Application No. _____ TRANSFER B-153
Permit No. _____
IN NAME OF

CORVALLIS LIVESTOCK AUCTION MKT.

Surveyed Nov. 12, 1969, by L. E. Gould