


T.38S.,R.3W.,W.M.

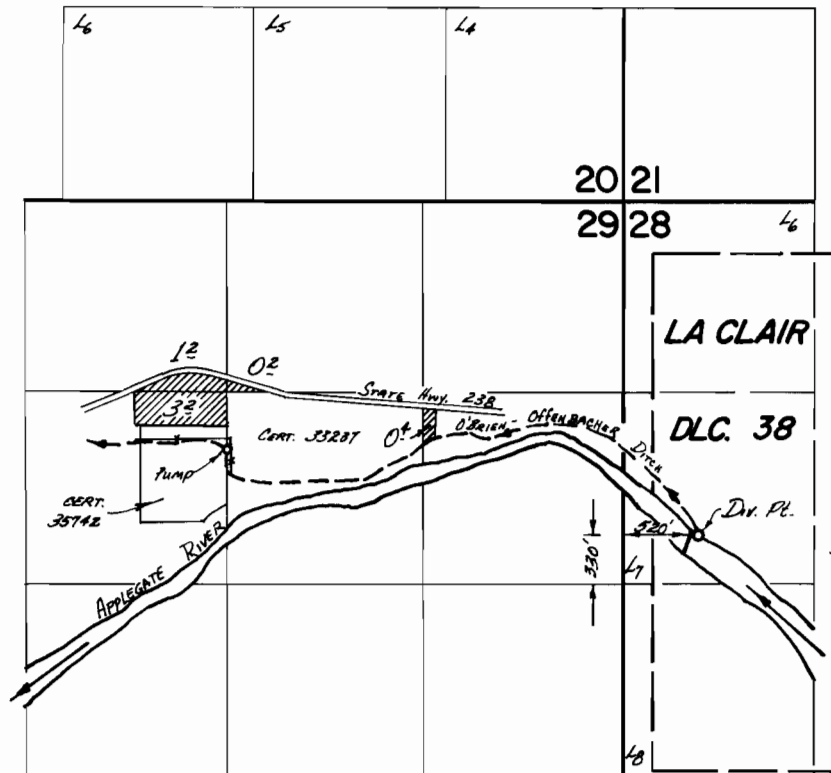

FINAL PROOF SURVEY UNDER

Transfer No. B-160
 Application No. _____ Permit No. _____
 IN NAME OF

HARLAN P & MARIE M. BOSWORTH

Surveyed Oct. 18 1973, by D. NORBY