


T. 6 S., R. 4 W., W. M.

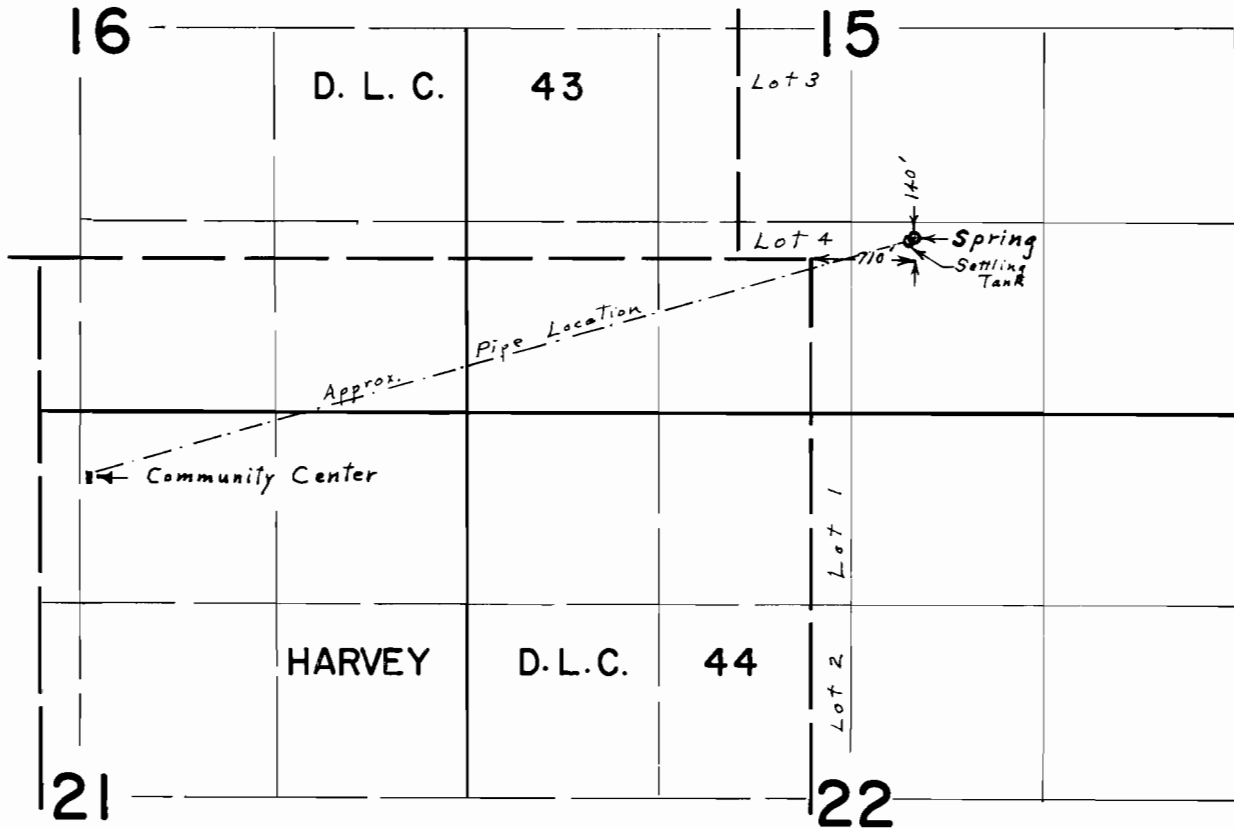

FINAL PROOF SURVEY UNDER

Application No. _____ Transfer B-165
Permit No. _____

IN NAME OF

BETHEL COLLEGE BOARD

Surveyed April 27, 1972, by L. E. Gould.