


SEC. 21, T. 36 S., R. 4 W., W.M.

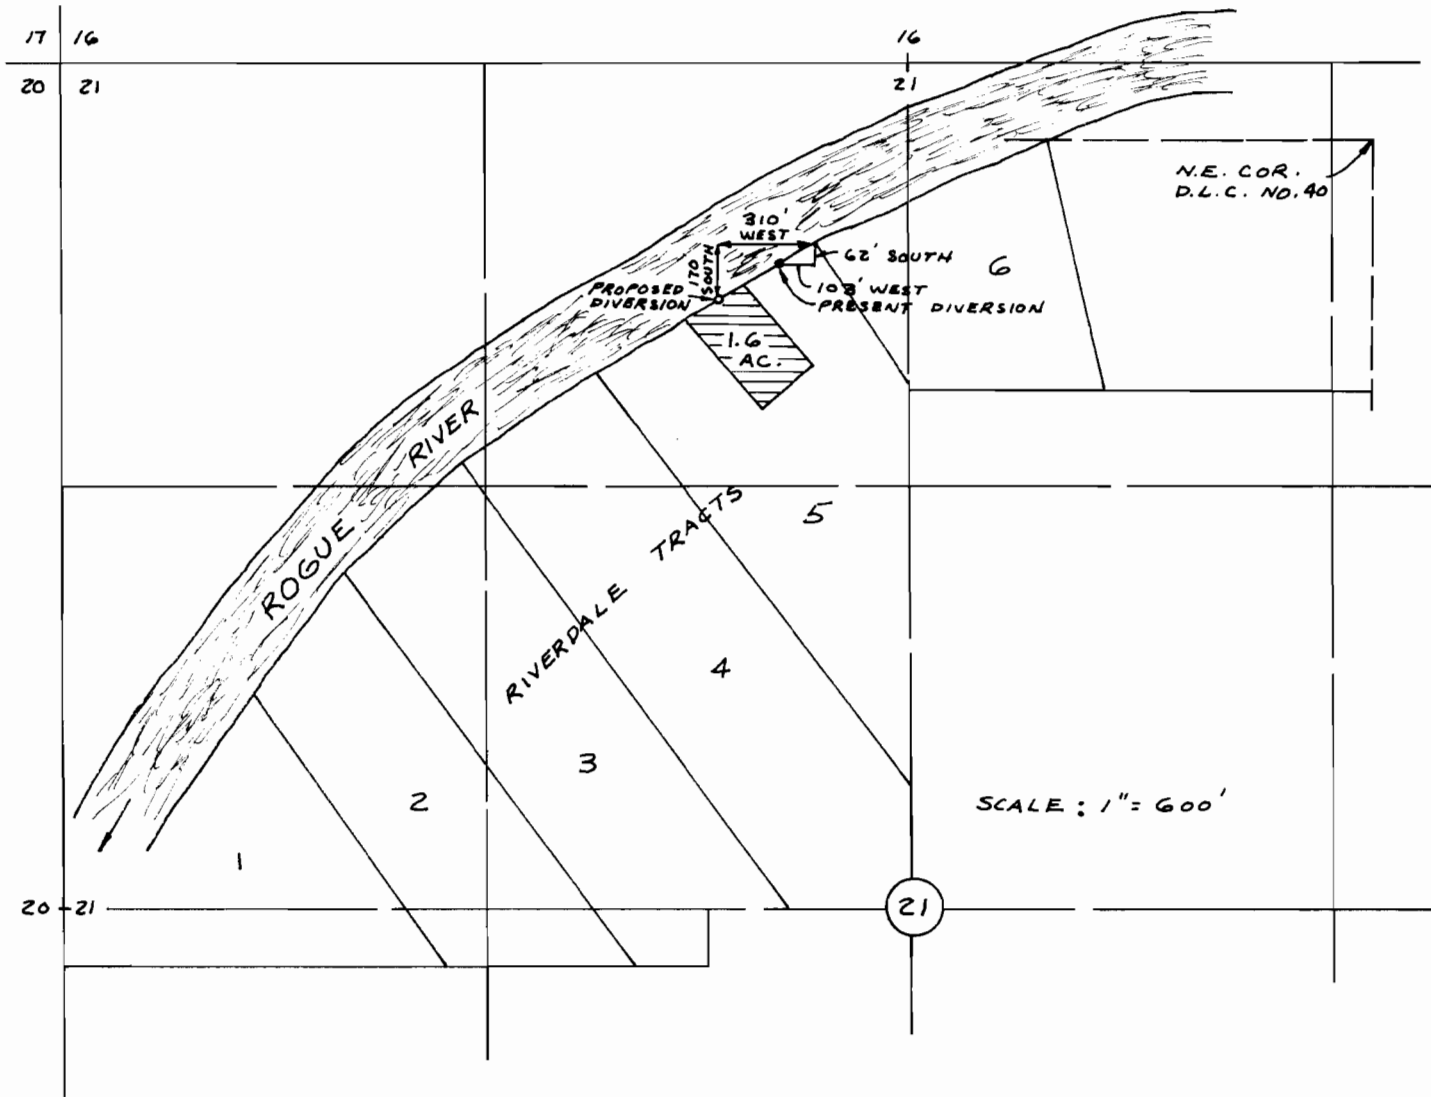

MAP TO ACCOMPANY APPLICATION OF OSCAR C. AND BERTHA J. BROTHERS FOR
A CHANGE IN POINT OF DIVERSION

SEPT. 1, 1966