


T.13S. R.31E. W. M.

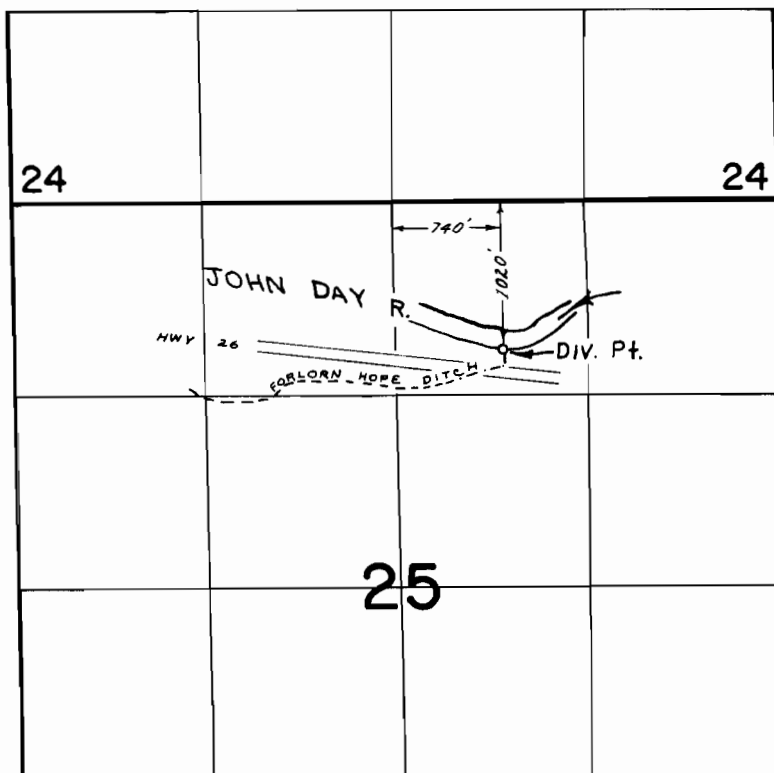

FINAL PROOF SURVEY
UNDER

Transfer No. B-189

Application No. Permit No.
IN NAME OF

.....
WALTER BADLEY
.....

Surveyed JUNE 18 & 21, 1975, by R. MUCKEN