


T.6S. R.1W. W.M.

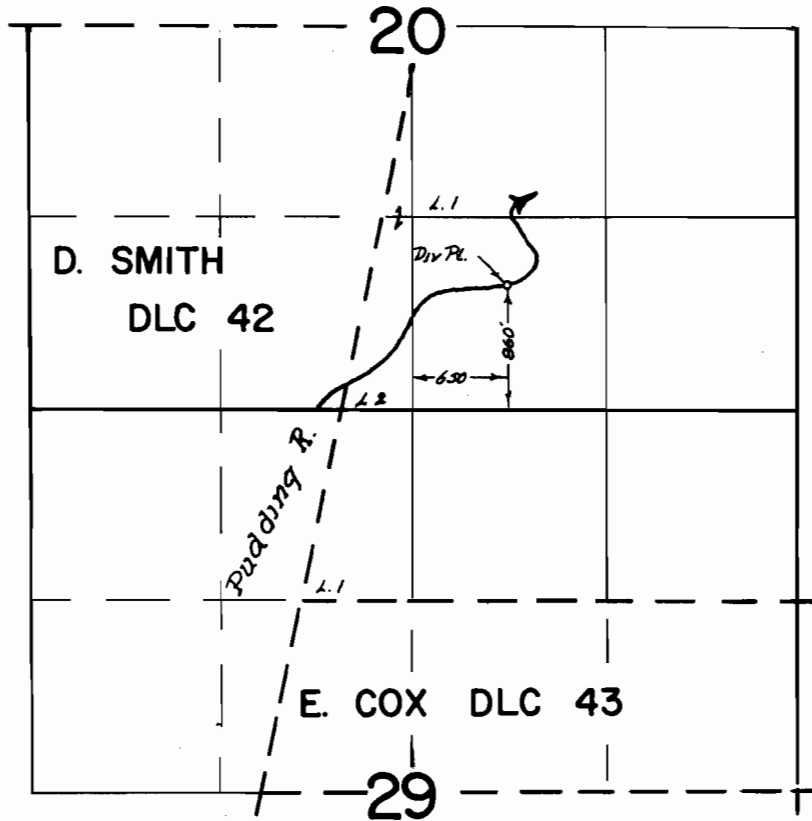

FINAL PROOF SURVEY
UNDER

Transfer No. *B-194*
Application No. _____ Permit No. _____
IN NAME OF

WILLIAM G BERGMANN

Surveyed *June 16, 1972*, by *R. E. Musken*.