


T.29S.,R.4W.,W.M.

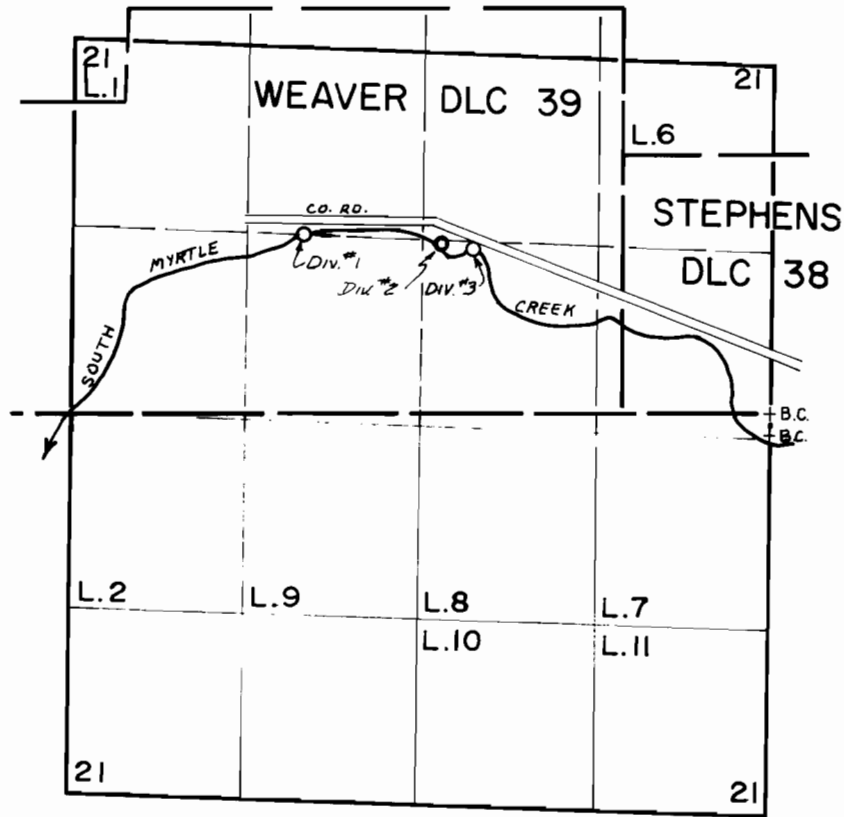

Div. Pts. Loc.: *1-1400 ft N. & 3200 ft W.; *2-1320 ft N. & 2250 ft W.; *3 1300 ft N. & 2040 ft W.; all from E $\frac{1}{4}$ Cor Sec 21
 Div. Pts *1 & *3 - Transfer B-198
 Div. Pt *2 - Transfer 4638

FINAL PROOF SURVEY UNDER

Transfer No. B-198

Transfer No. 4638

IN NAME OF

.....HOWARD BROWNSON.....

Surveyed April 20 1978, by D. SPARKS.....