


# T.3 S. R.1 E. W.M.

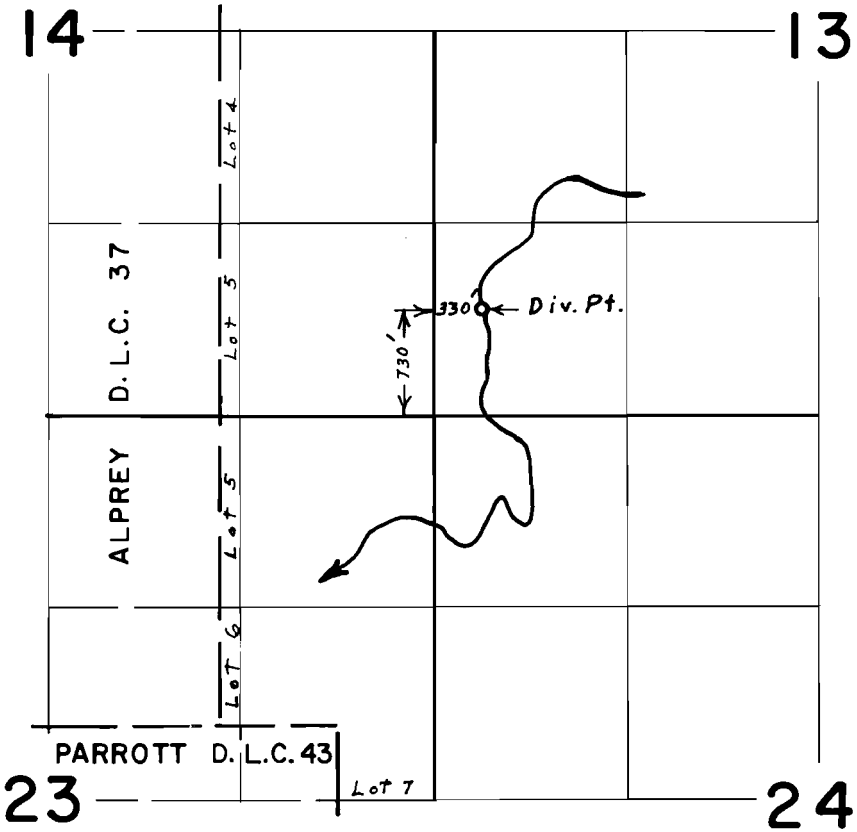

## FINAL PROOF SURVEY UNDER

Application No. .... Transfer No. B 202  
Permit No. ....

IN NAME OF

DAVID F. & DEANN L. PFLEGL

Surveyed April 21, 1976, by L. E. Gould