T.4S. R.2&3W. W.M.

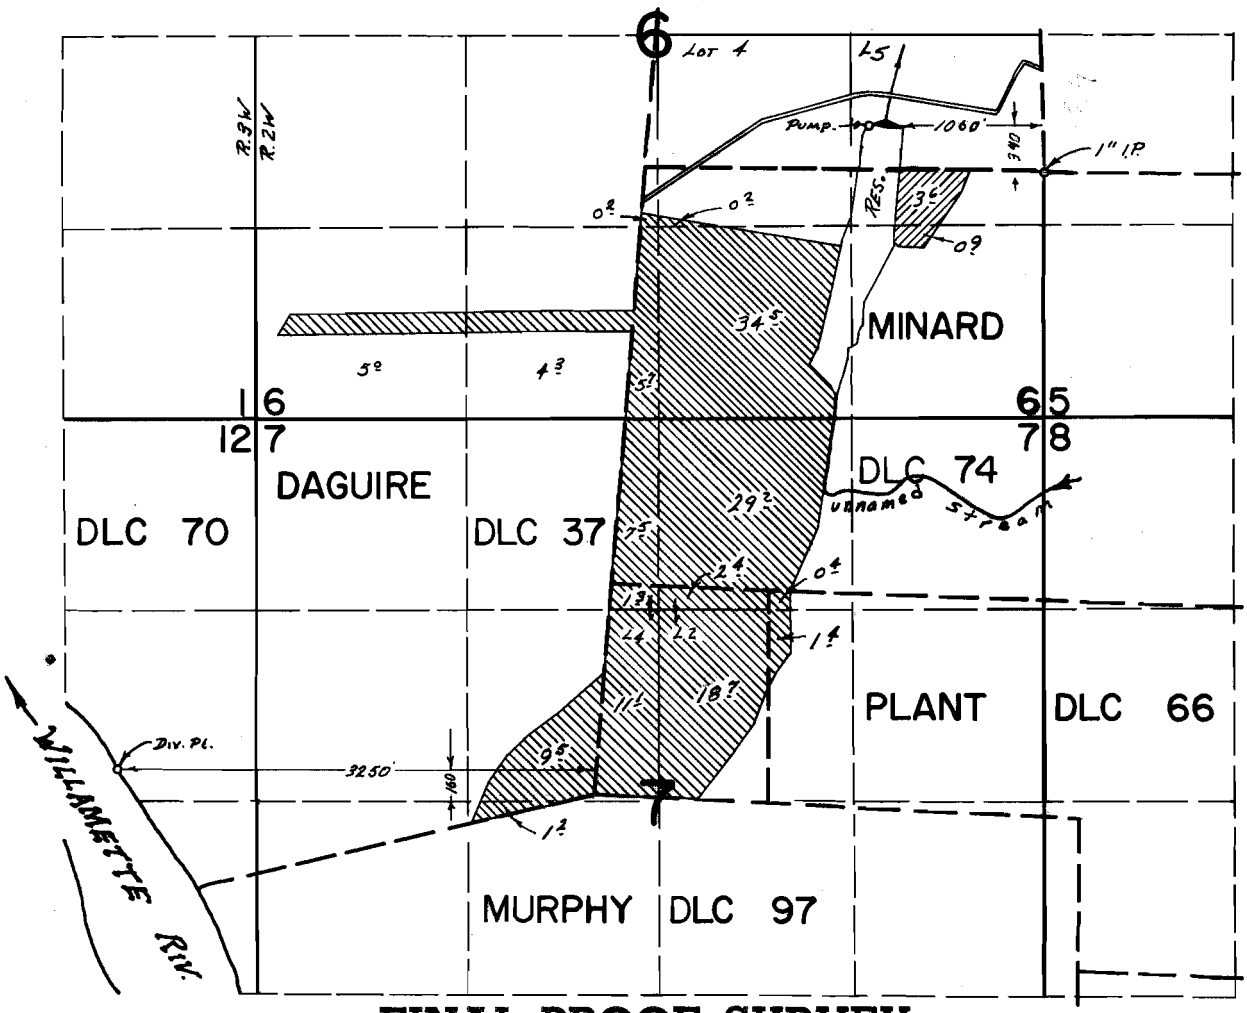

FINAL PROOF SURVEY
UNDER

Transfer No. C-184
Application No. 44511 Permit No. 33310
IN NAME OF

IRMA L. CALKINS

Surveyed JUNE 6. 1973, by R. G. MUCKEN

DFQ-ACC-12