


T.16S.R.23E.W.M.

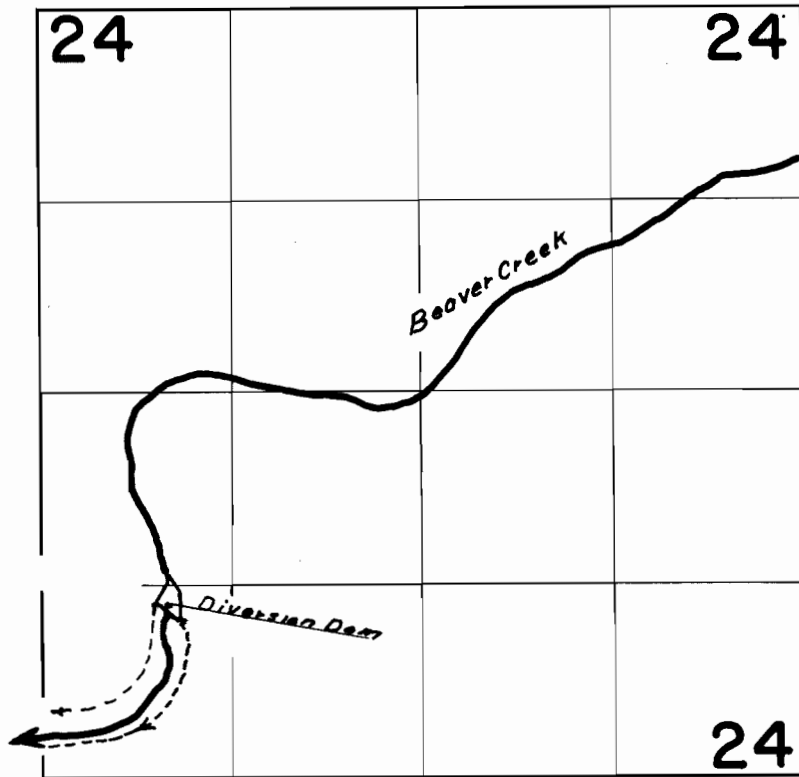

FINAL PROOF SURVEY
UNDER

Transfers C-3 & C-5

Application No. Permit No.

IN NAME OF
C. S. CONGLETON
GLEE CONGLETON & FRED GRAY,

Surveyed Oct. 7, 1964, by *C. J. Gardner*