


24

TOWNSHIP 158, RANGE 10E, W. M.

North

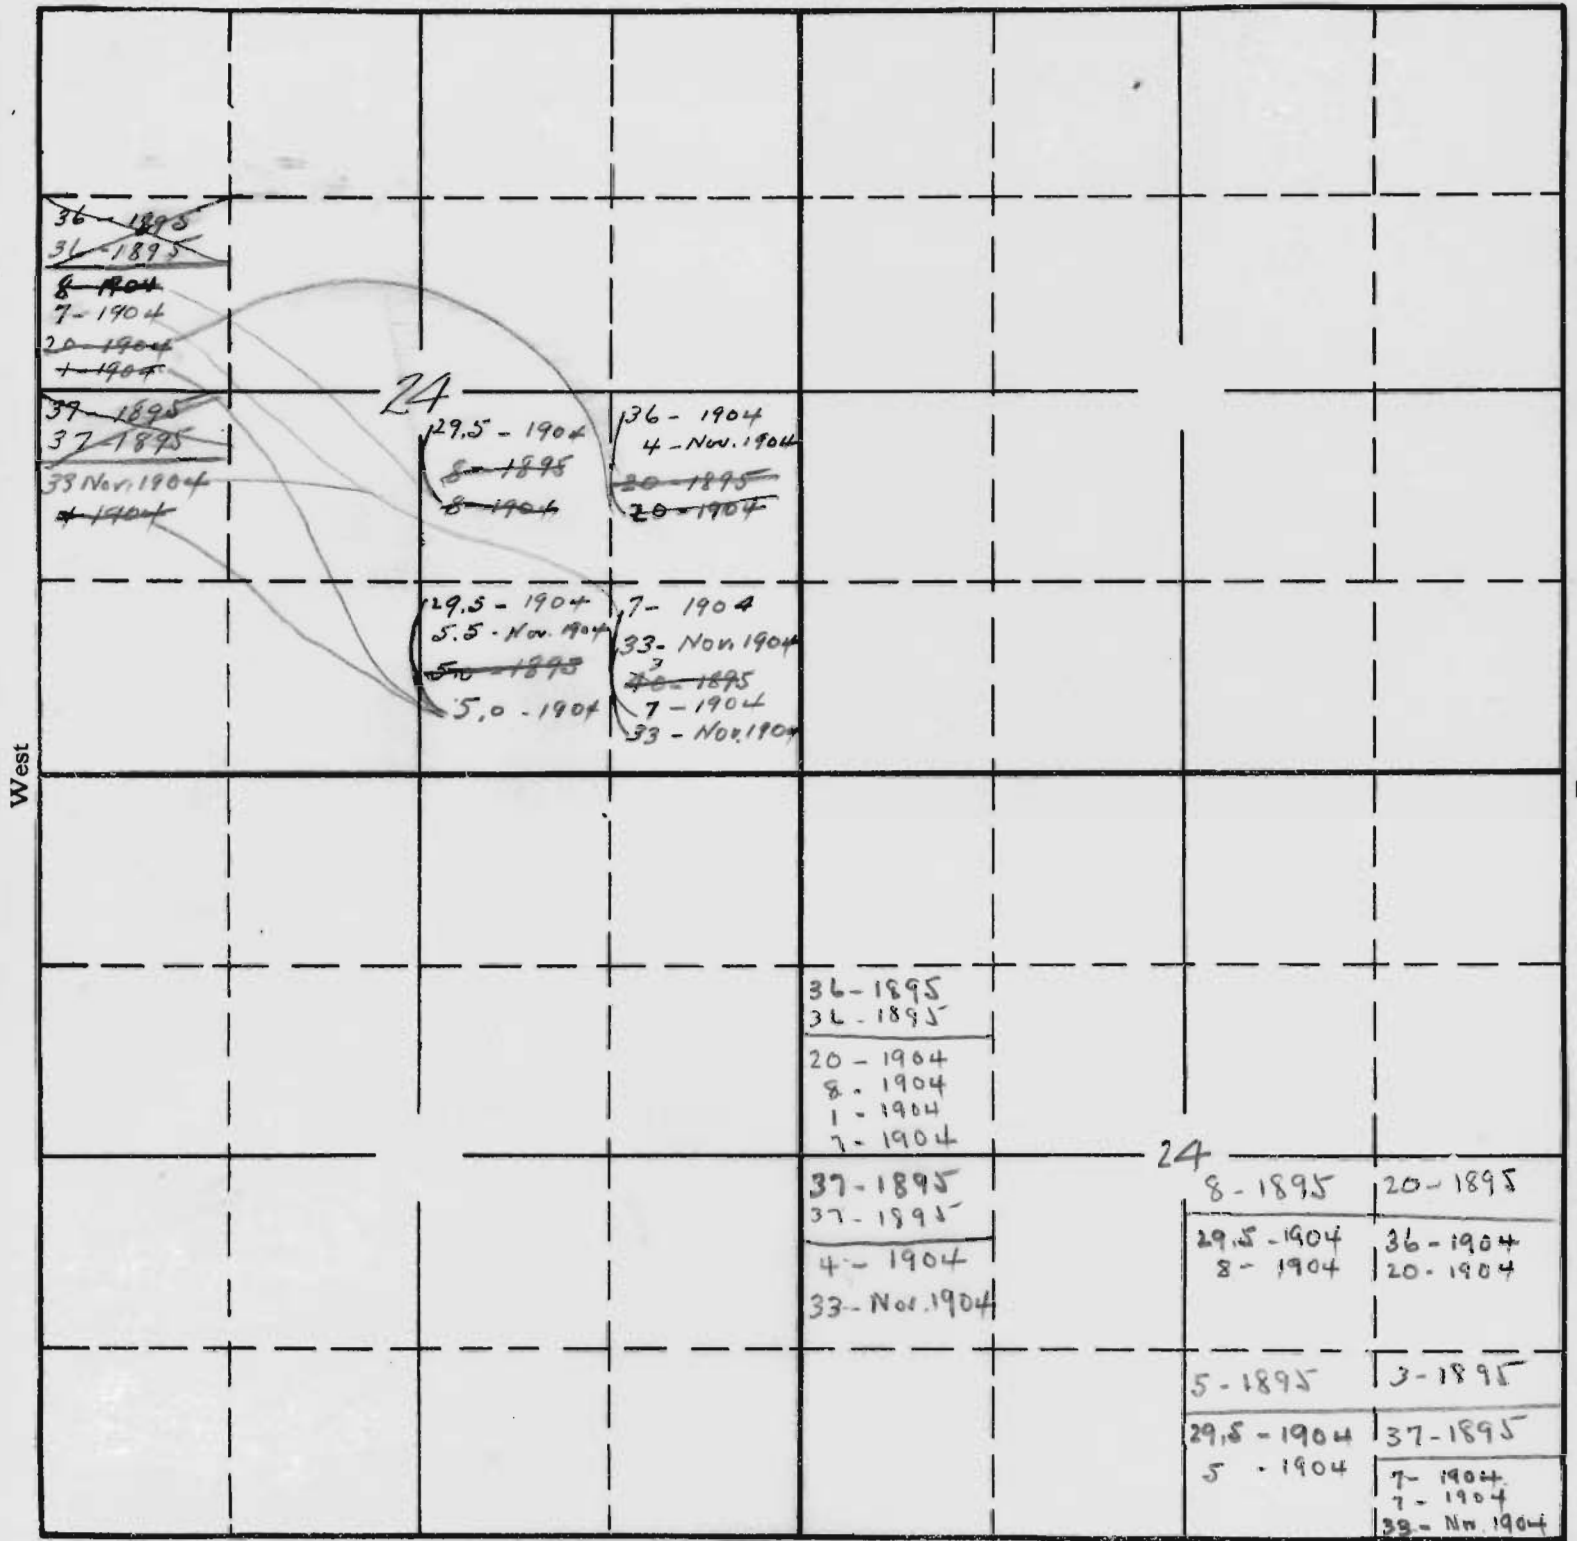

South

Penciled figure denote Original water rights  
 Red " " acreage transferred from  
 Blue " " " " " " to

APPLICATION No.  
 PERMIT No.

C-T