


T.16S. R.23E. W.M.

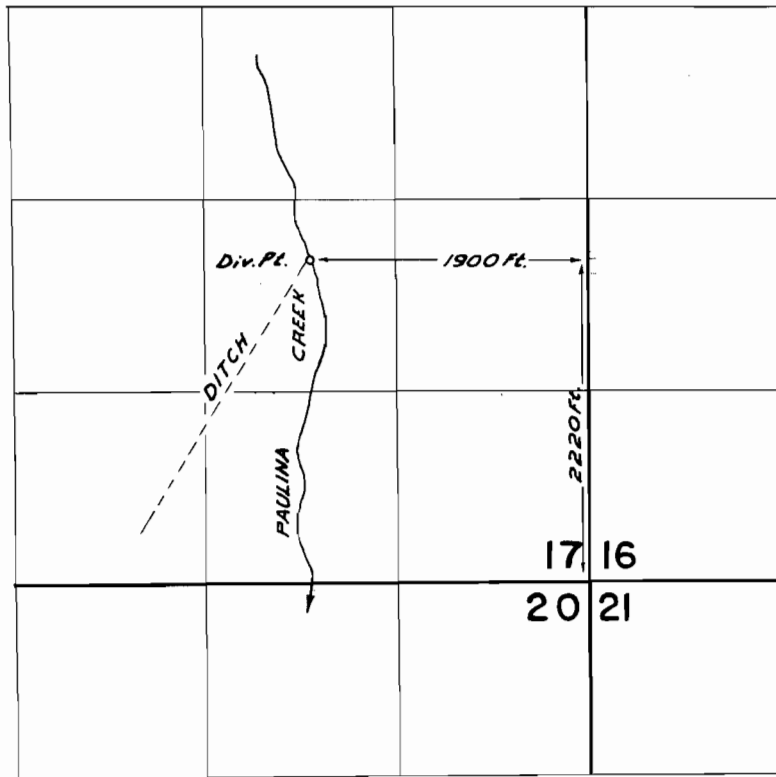

FINAL PROOF SURVEY
UNDER

TRANSFER C - 72

Application No. _____ Permit No. _____

IN NAME OF

LES THOMAS

Surveyed OCT. 6 1964, by C. GARDNER