


T.5 S. R. 11 E. W.M.

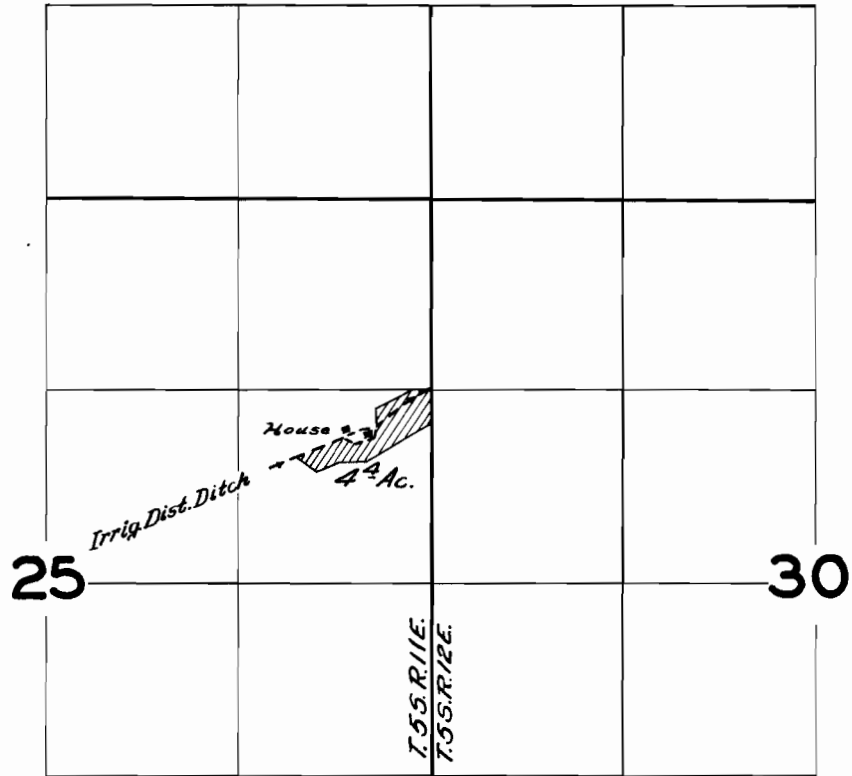

FINAL PROOF SURVEY
UNDER


Transfer No. C-85

IN NAME OF

C. F. Cox

Surveyed *Oct. 11* 19*57*, by *C.O. Bartels*

T. 5 S. R. 11 E. W.M.

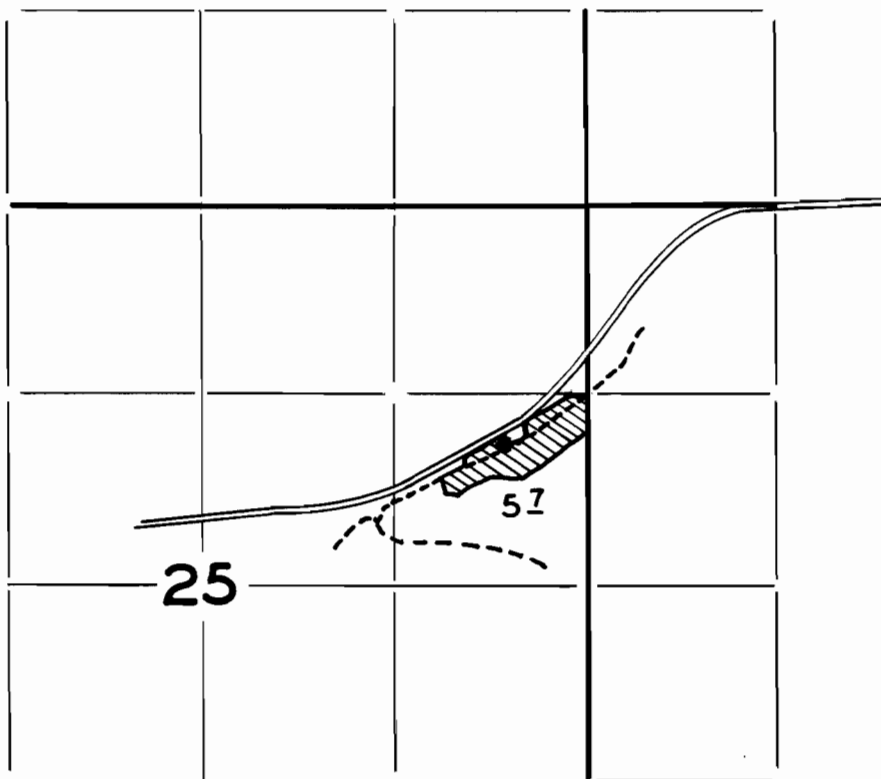

FINAL PROOF SURVEY
UNDER

TRANSFER: C - 85

IN NAME OF

B. F. LINN

Surveyed OCT. 3, 1960, by W. CARR