


T. 20S. R. 41 & 42E.W.M.

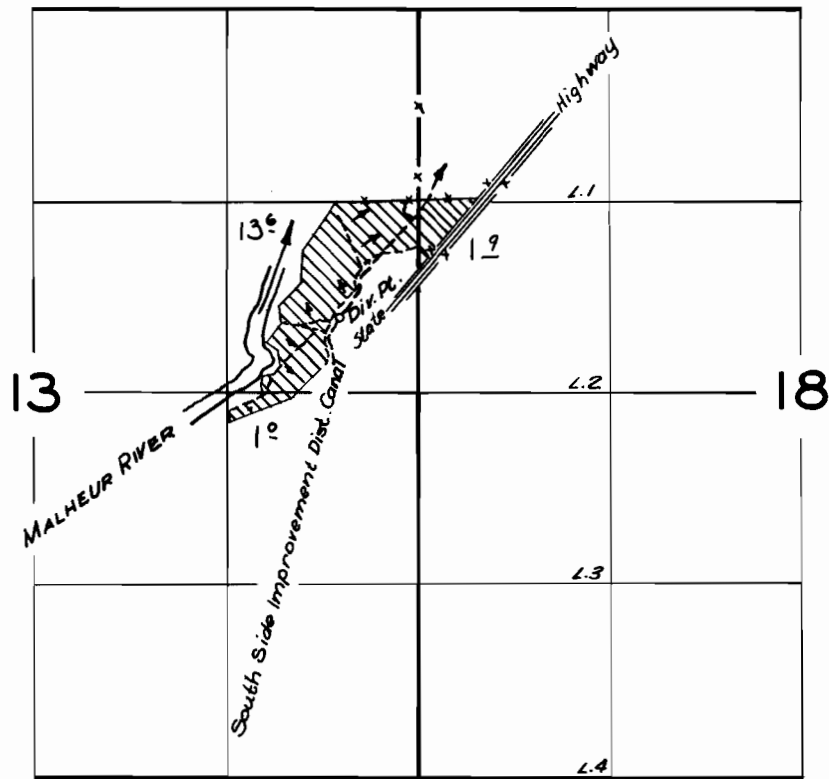

FINAL PROOF SURVEY
UNDER

TRANSFER NUMBER C-101
IN NAME OF

L. P. CHASTAIN

Surveyed 28. Oct. 1958, by C. O. Bartels.