


# T.5 S.R.13 E.W.M.

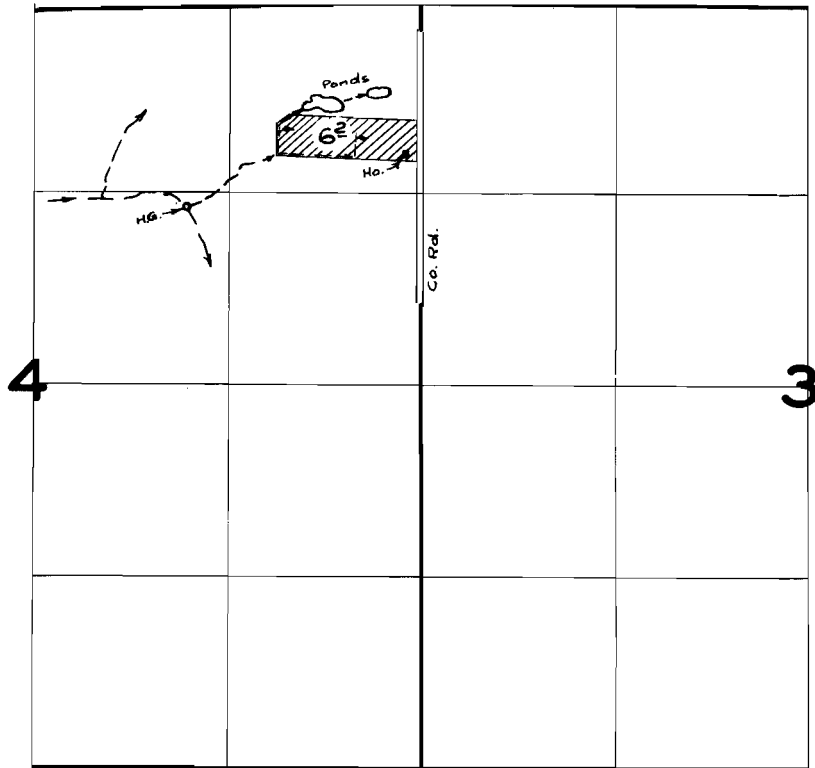

## FINAL PROOF SURVEY UNDER

TRANSFER No. C-122

Application No. \_\_\_\_\_ Permit No. \_\_\_\_\_  
IN NAME OF

..... HAZEL DELORE .....

Surveyed 12 Nov. 1959, by M. Bish