


T.14S. R.13E.W.M.

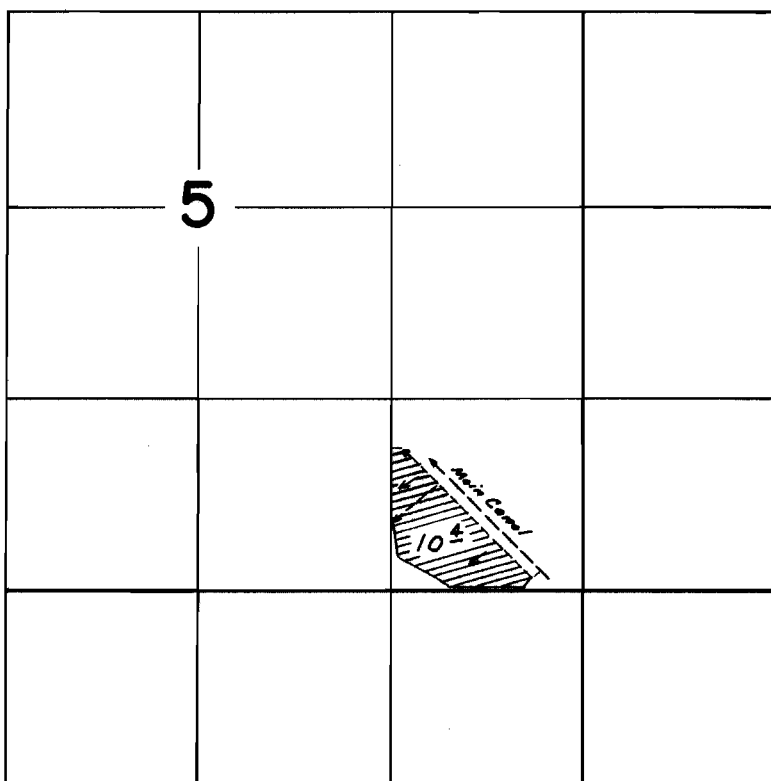


FINAL PROOF SURVEY
UNDER

Transfer No. C-126
Application No. Permit No.
IN NAME OF

RALPH WILKONSON

Surveyed August 25, 1965., by *Clayton J. Gardner*

T.18S.R.12E.W.M.

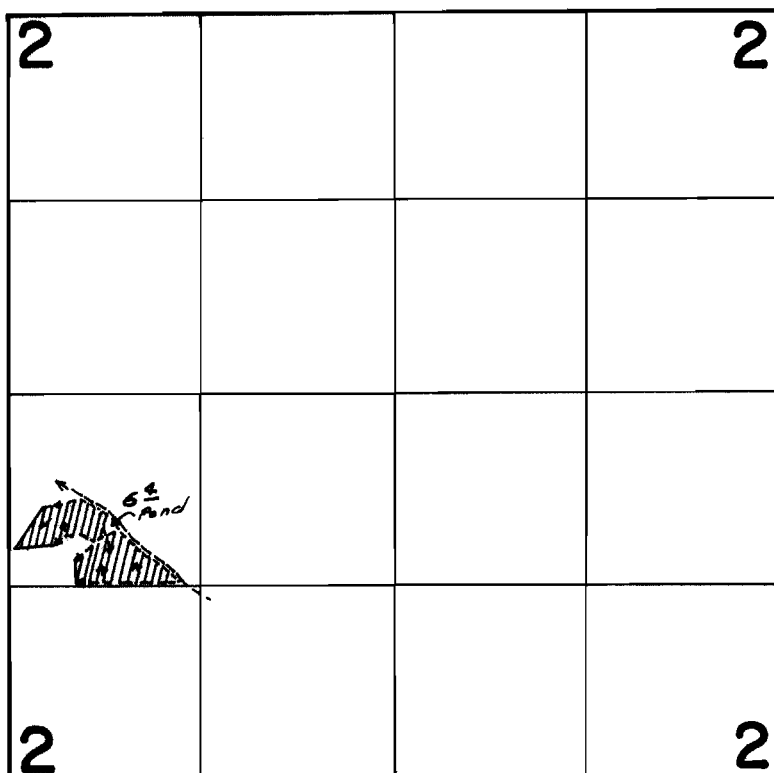

FINAL PROOF SURVEY UNDER


Transfer No. C-126
Application No. _____ Permit No. _____

IN NAME OF

RICARDO ARTERO

Surveyed August 27, 1965, by *Clayton Kardus*

T. 18S. R. 12E. W.M.

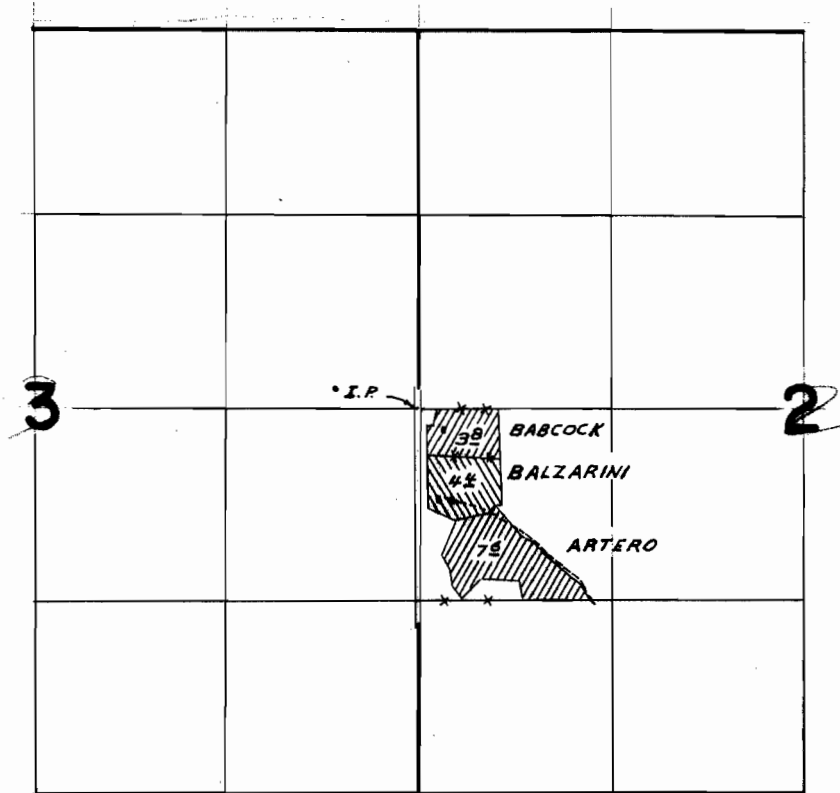

FINAL PROOF SURVEY
UNDER

Transfer C-126
Application No. Permit No.
IN NAME OF

.....
Surveyed *MAY 5, 1966*, by *W.U. Ruppert*