

6	5	4	3	2	1		
			5'				
7	8	9	10	11	12		
		4'		5'	5'		
		3'					
		107-9-3504					
18	17	16	15	14	13		
		5'	8'	24'	7'	5'	
		10'		8'	12513-321	107-9-321	
		37-4-338	3 Ricks	15-9-466			
		77-2-474	27-2-351				
		5+3'			11'	3'	5'
		7'	2'		24-9-466	20-9-466	20-9-466
		1 BANK					
		17-3-366					
		27-4-370					
		27-3-334					
19	20	21	22	23	24		
	10'	4'					
		16-9-466					
		11'					
		30-9-466					
30	29	28	27	26	25		
	7'						
31	32	33	34	35	36		
				5'			
				15-9-466			
lot 4	10'	15'	4'				
25'	10'						
25-9-468	20-9-802	28-9-468					

Township 14 S

Range 14 E

W.M.

Crook County

6

5

4

3

2

1

7

8

9

10

11

12

18

17

16

15

14

13

17
11
17-T5-163

Lot 2
21
01

19

81
01

20

21

22

23

24

101
01

30

29

28

27

26

25

31

32

33

34

35

36

5
347.3-346

Township 14 S Range 15 E W.M. Crook County

6	5	4	3	2	1
7	8	9	10	11	12
18	17	16	15	14	13
19	20	21	22	23	24
30	29	28	27	26	25
31	32	33	34	35	36
61 01					

Township 15 S Range 12 E W.M. Duschutes

6

5

4

3

2

1

7

8

9

10

11

12

18

17

16

15

14

13

19

20

21

22

23

24

30

29

28

27

26

25

31

32

33

34


35


36

10 ✓
0 ✓

20 ✓
20-9-470


Lot 4 30 30-9-470	Lot 3 5 Excess 10 5-9-470			Lot 4 10 1074-150 1075-43	Lot 1 3 28-9-470						
6	11 5 23-9-470 20-9-470 7 Excess	5	4	3	2	1					
		9 19-9-470		5 20-9-470 1075-123							
7		8	9	10	11	12					
25 28-9-471		6 30-9-471		9 40-9-471							
				8 40-9-471							
18		17	16	15	14	13					
			11 2 Excess 573-125 1074-123	31 01							
19		20	21	22	23	24					
51 01											
30		29	28	27	26	25					
31 27-9-473											
31		32	33	34	35	36					

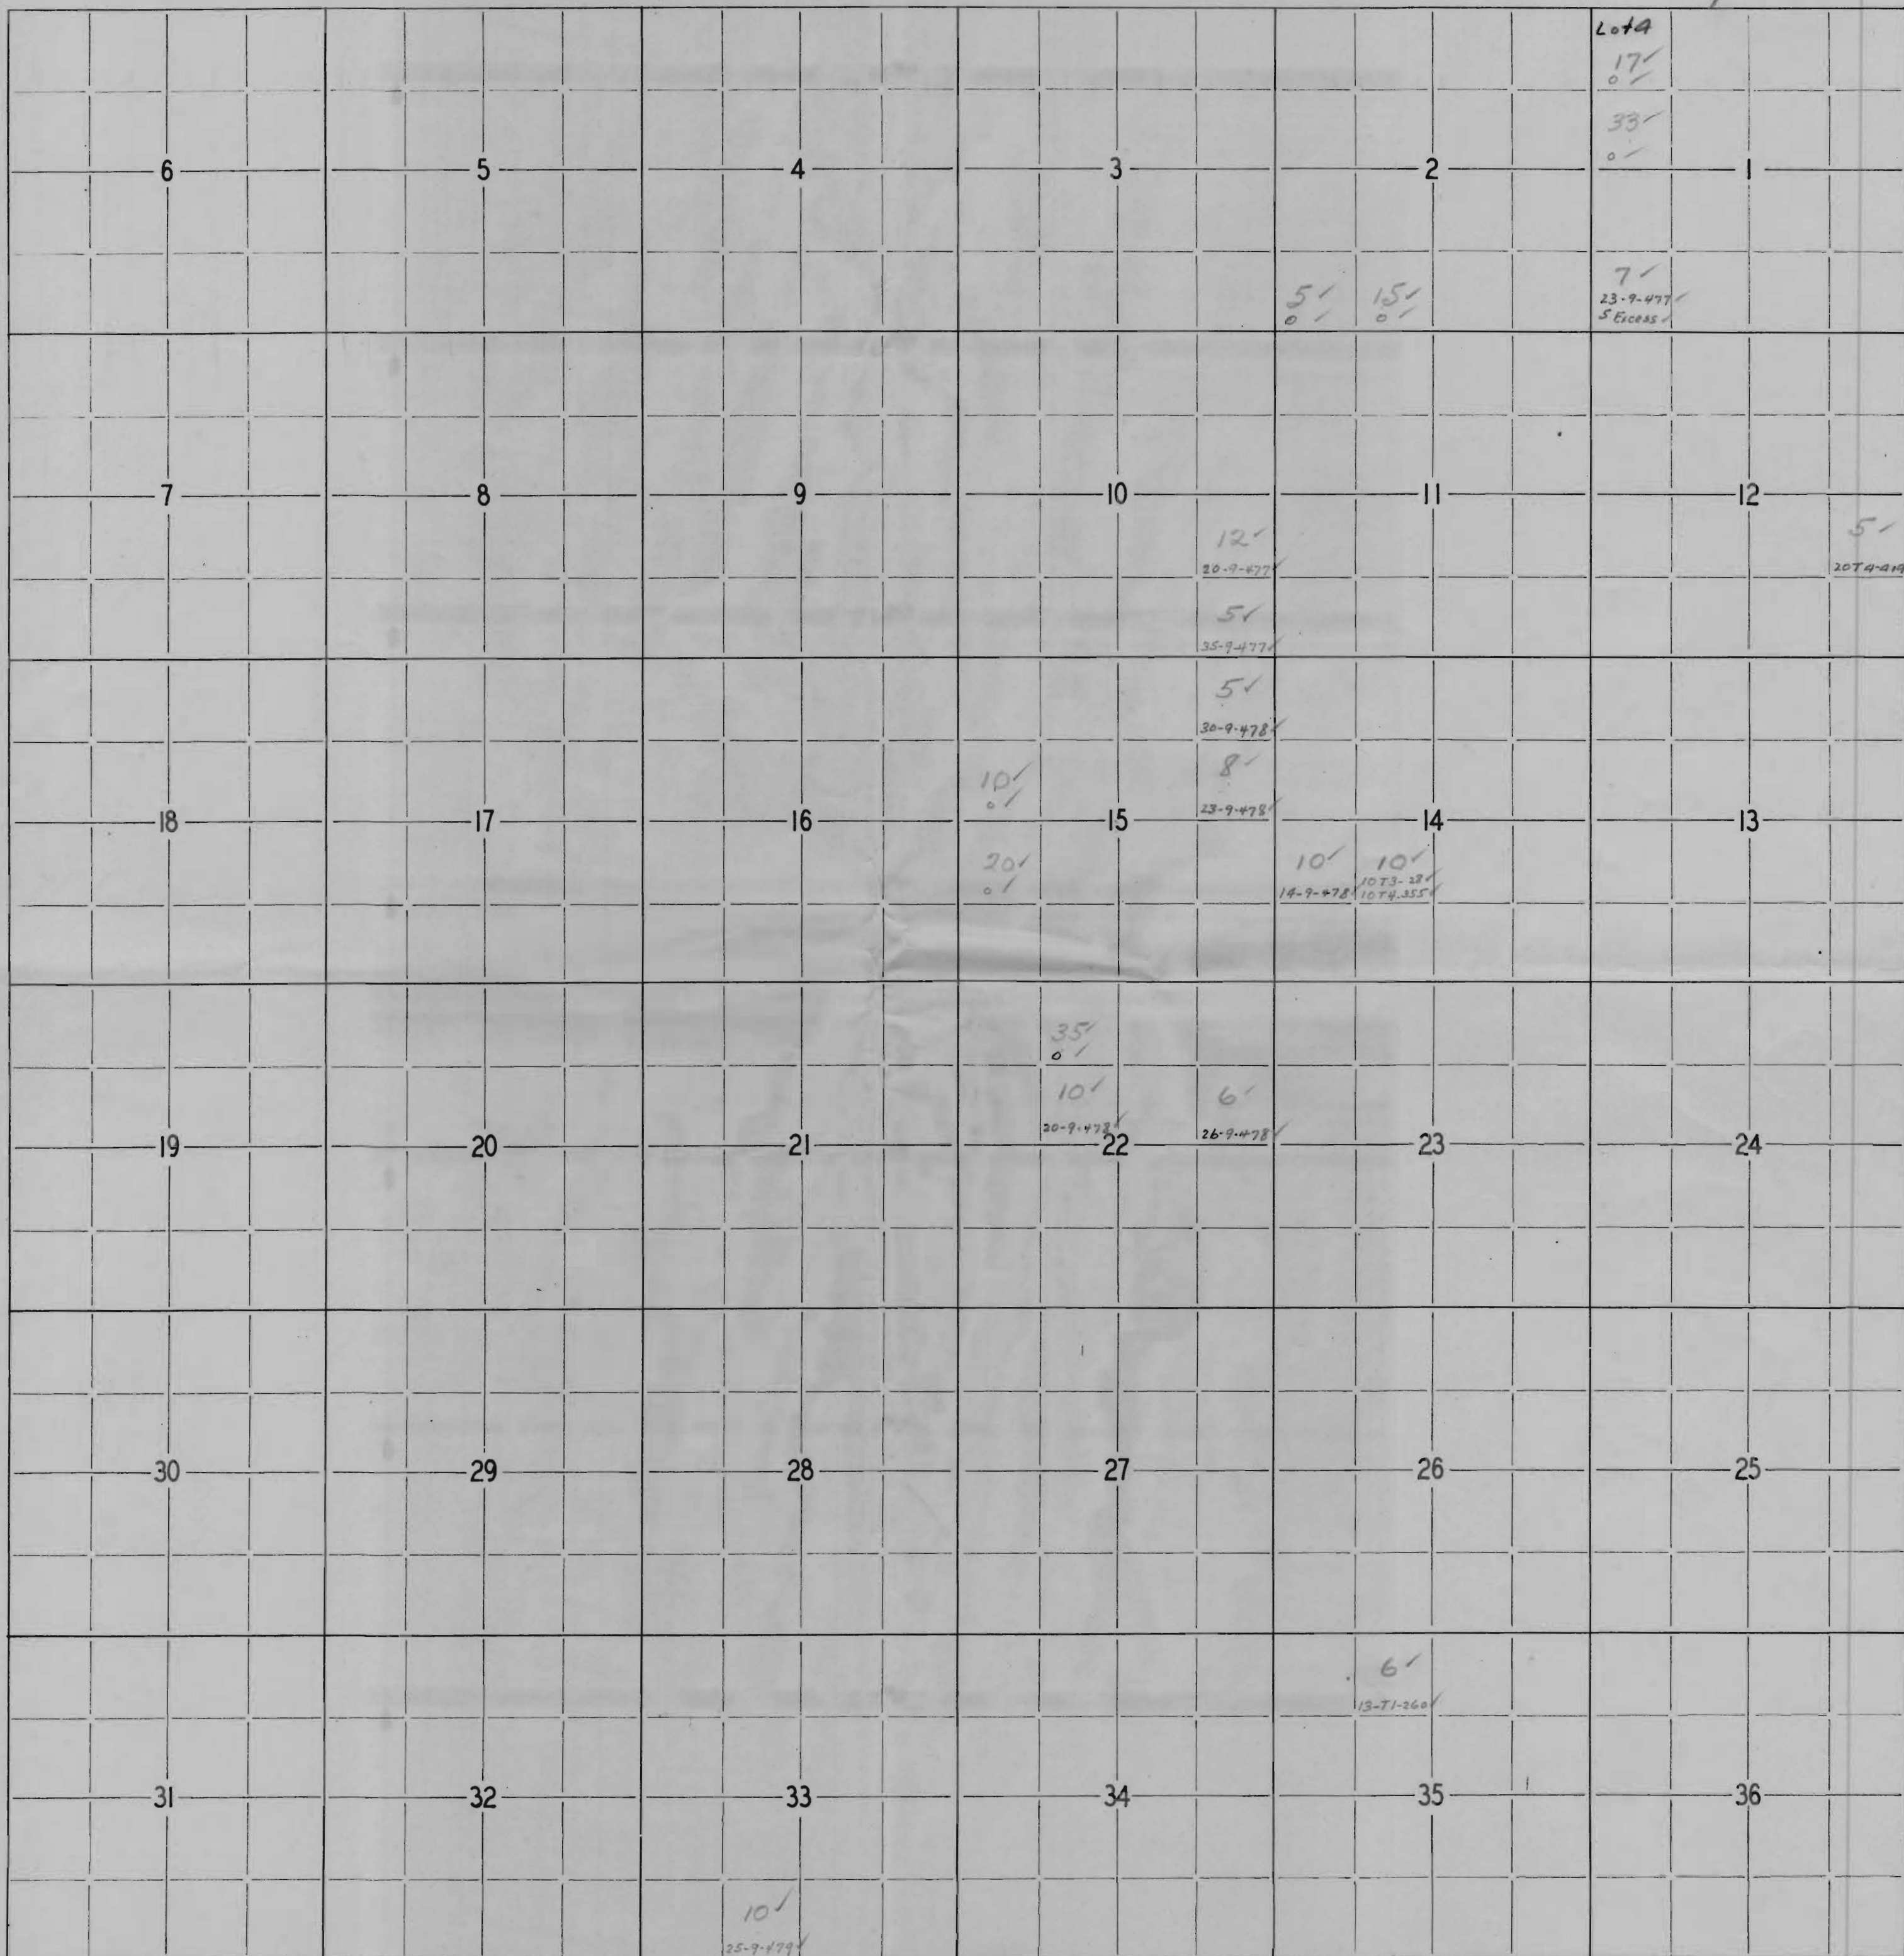

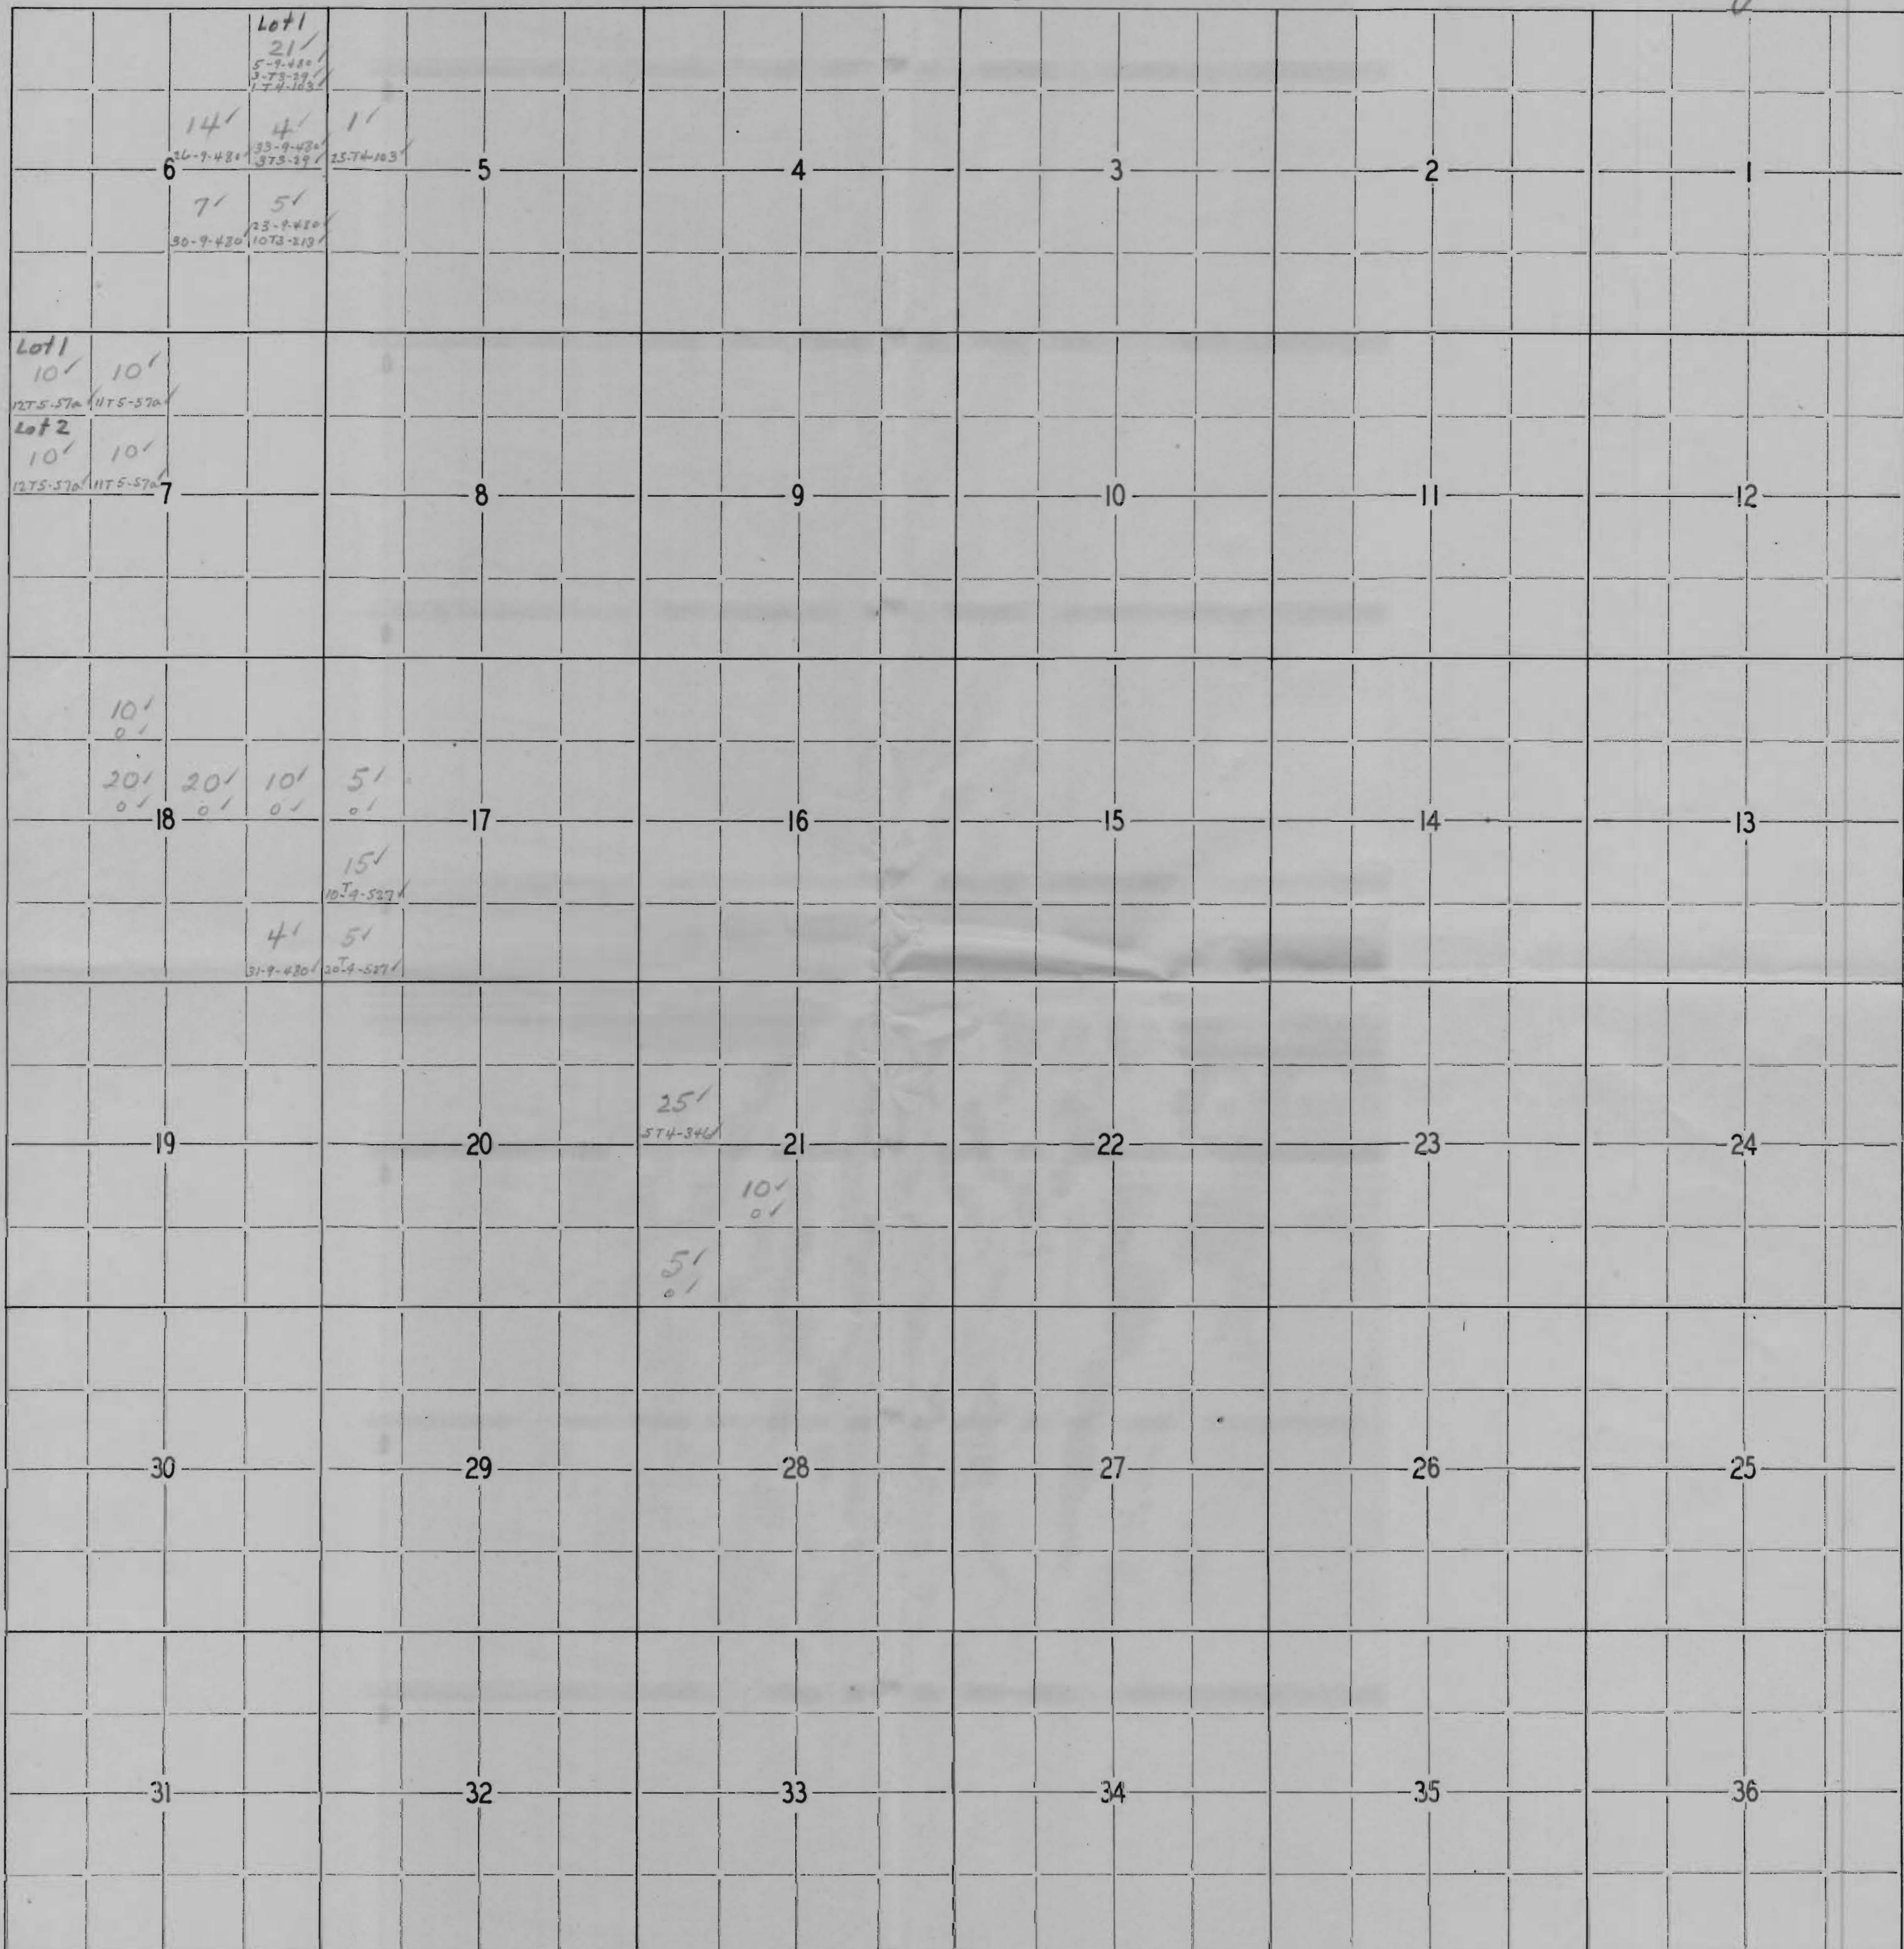


6	5	4	3	2	1				
7	8	9	10	11	12	26 37-7-473 3173-334-346 3074-400			
18	17	16	15	14	13				
19	20	21	22	23	24	23 4 22-9-474 33-9-474			
30	29	28	27	26	25	5 23-9-474 -16-704	10 21-9-474		
						19 2074-401 173-346 227-4-401	16 22-9-474 975-128	16	
						20			
						25 25-9-474			
31	32	33	34	35	36	22 22-9-474			

Township 17 S Range 12 E W.M. Daschuta

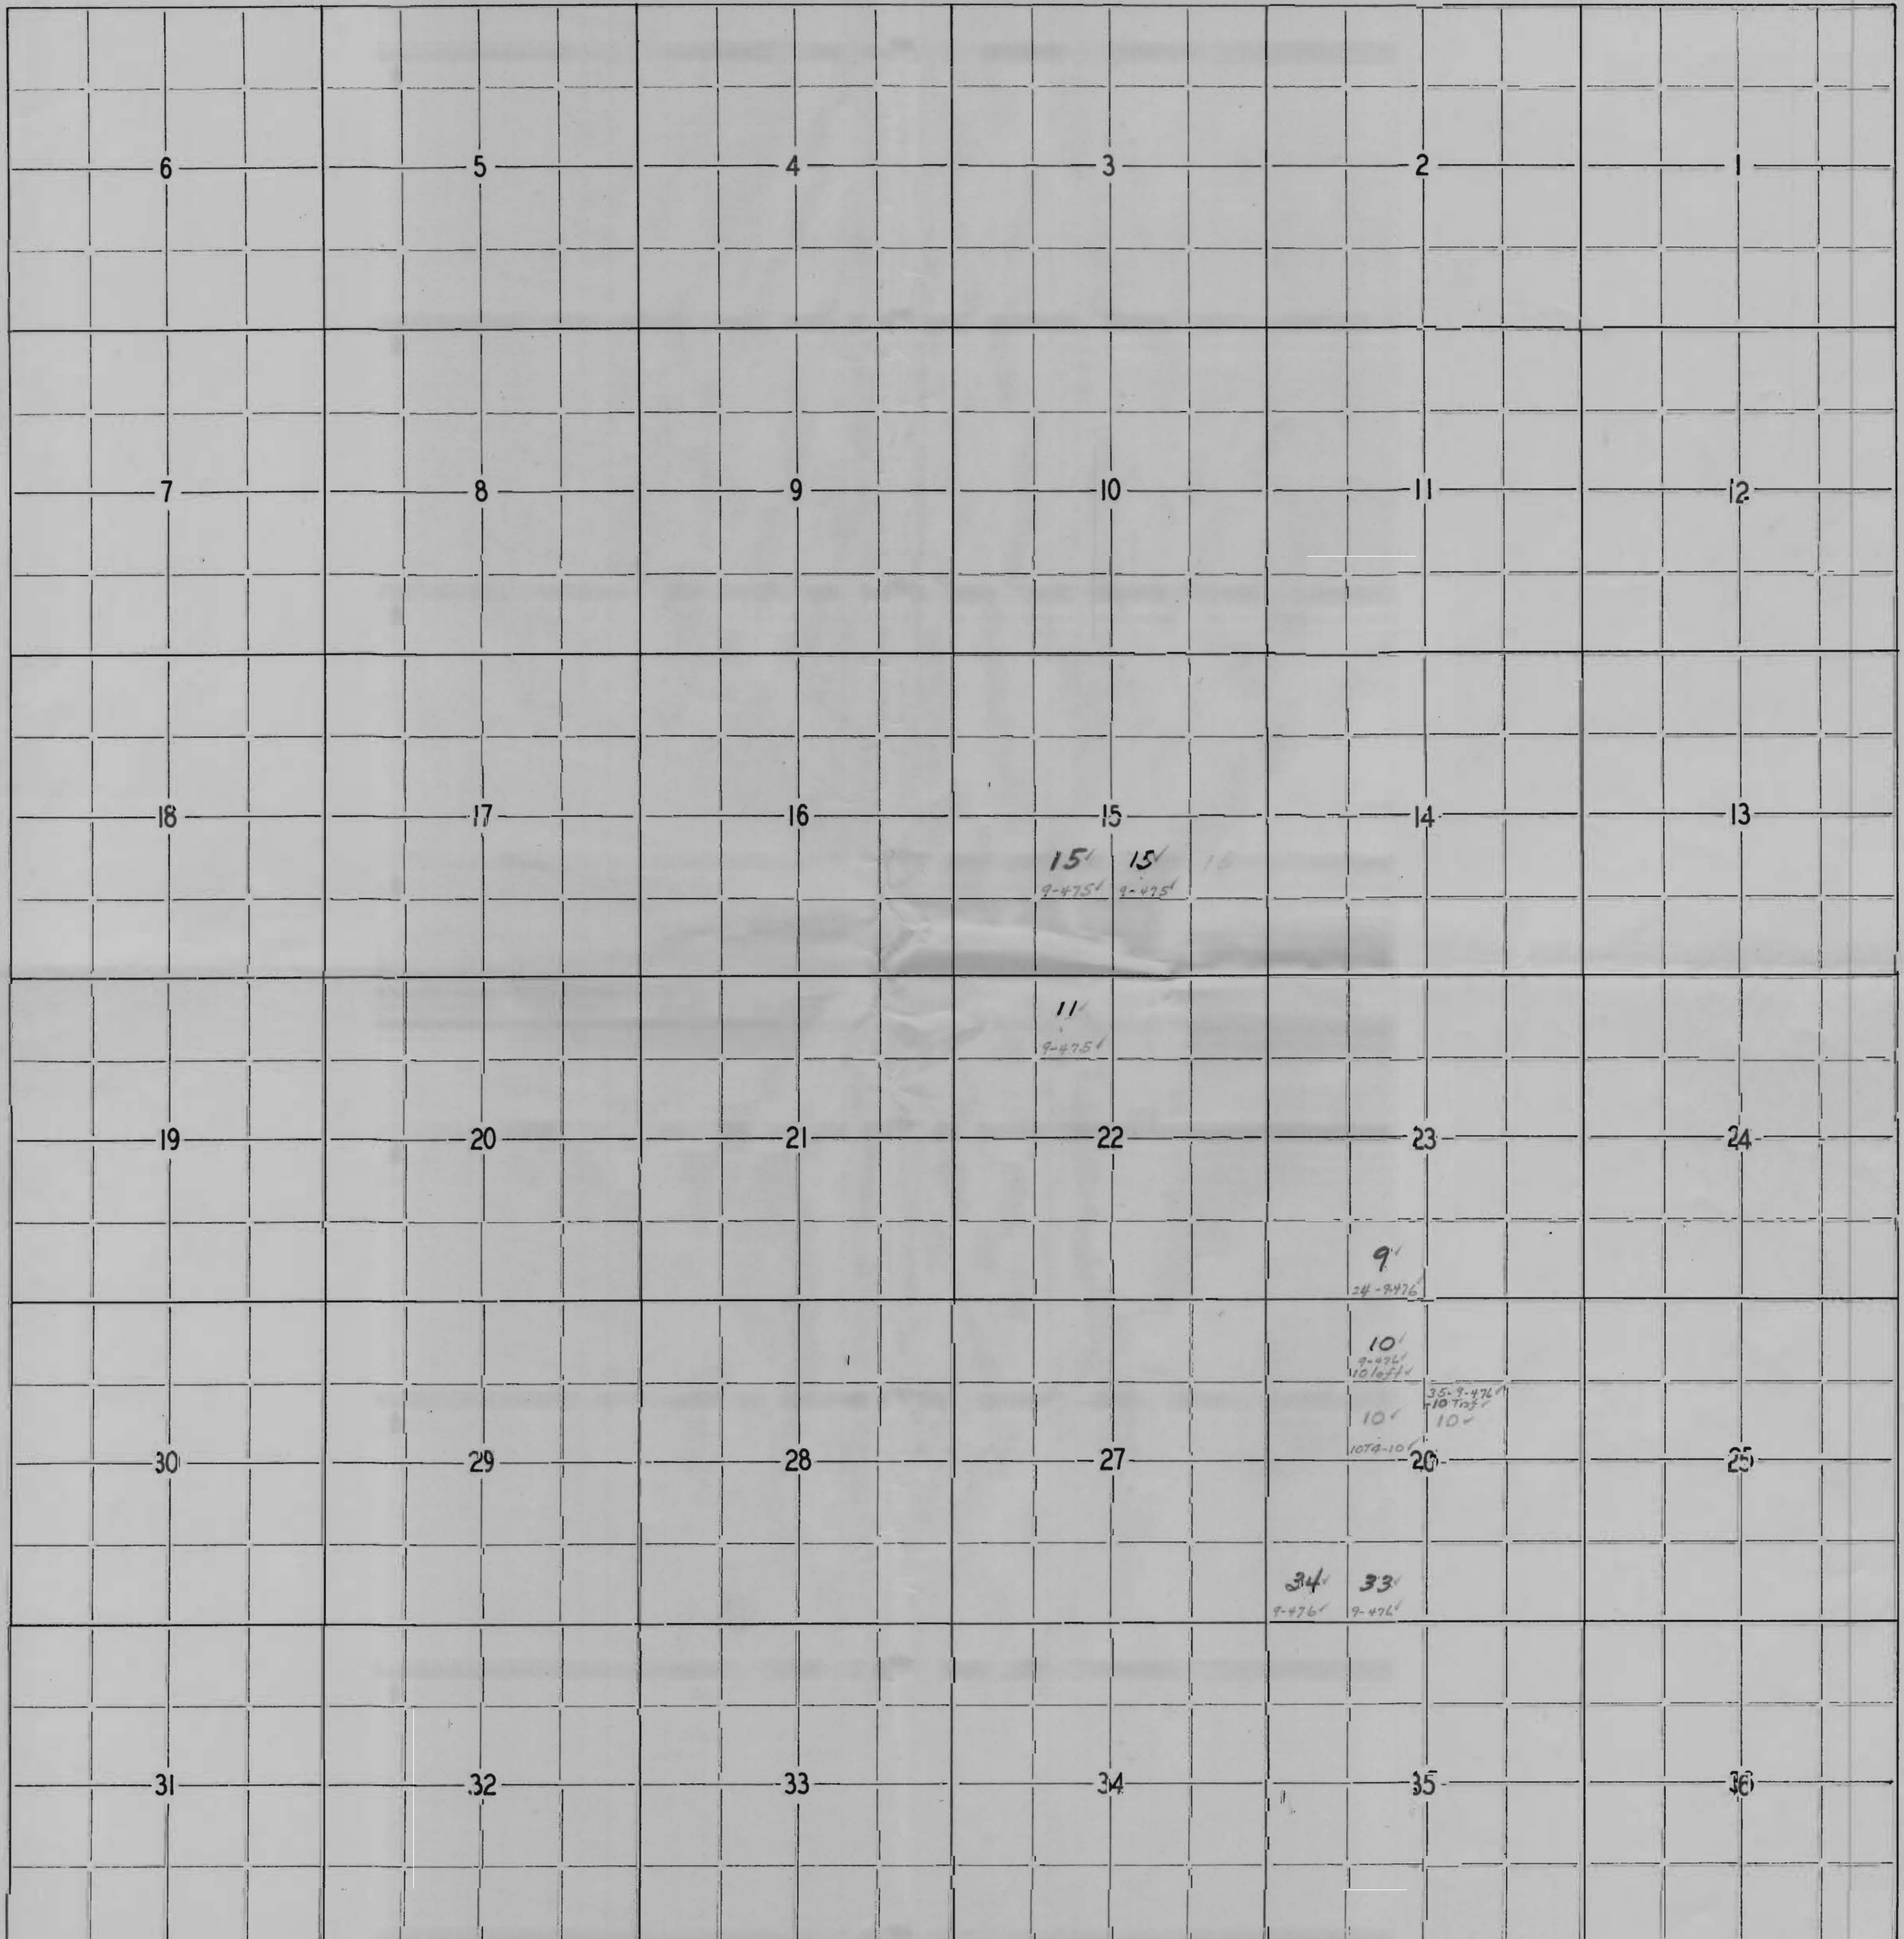

Township 17 S Range 13 E W.M. Deschutes County

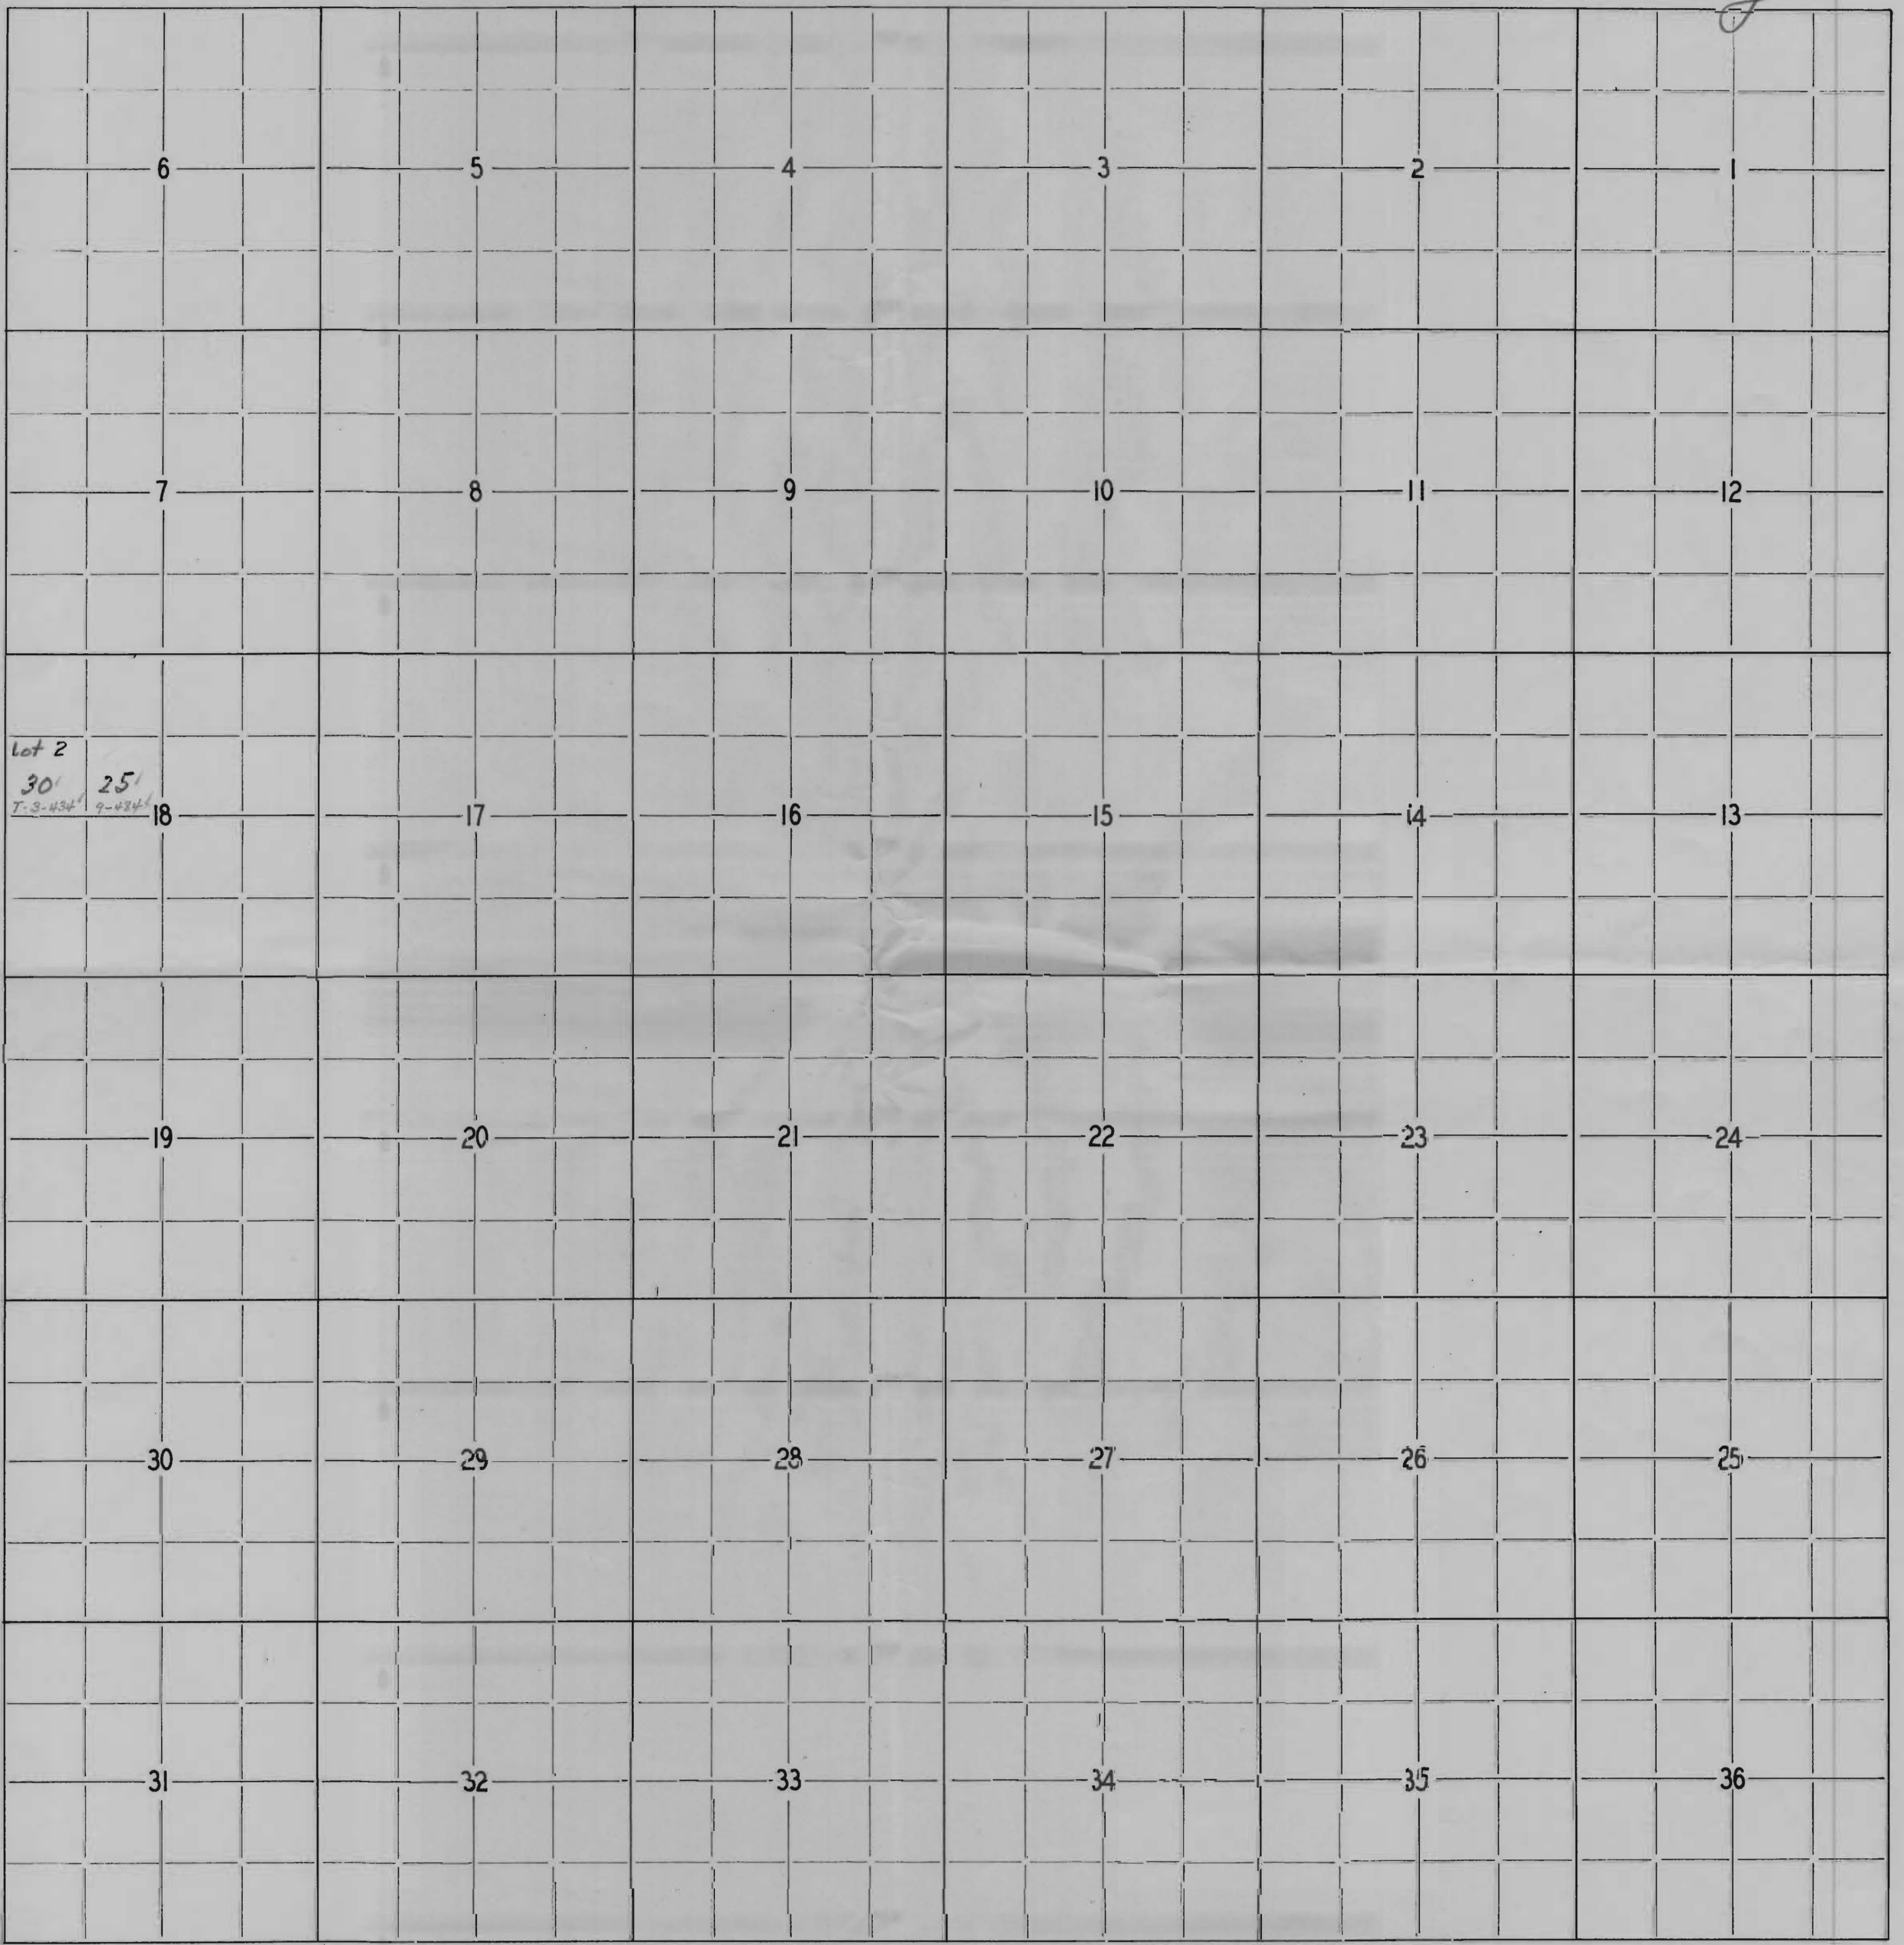

Township 18 S Range 12 E W.M. Daschuta County

Lot 4
5
11-9-458

10'
0'

6

5

4

3

2

1

7

8

9

10

11

12

18

17

16

15

14

13

19

20

21

22

23

24

30

29

28

27

26

25

31

32

33

34

35

36

Township 185 Range 14E W.M. Deschutes County

Lot 4 Lot 3
25' 35'
25-9-418 35-9-418
17'
28-9-418

6

5

4

3

2

1

7

8

35'
35-9-419

9

10

11

12

18

17

16

15

14

13

19

20

21

22

23

24

30

29

28

27

26

25

31

32

33

34

35

36