


T.15S.R.12E.W.M.

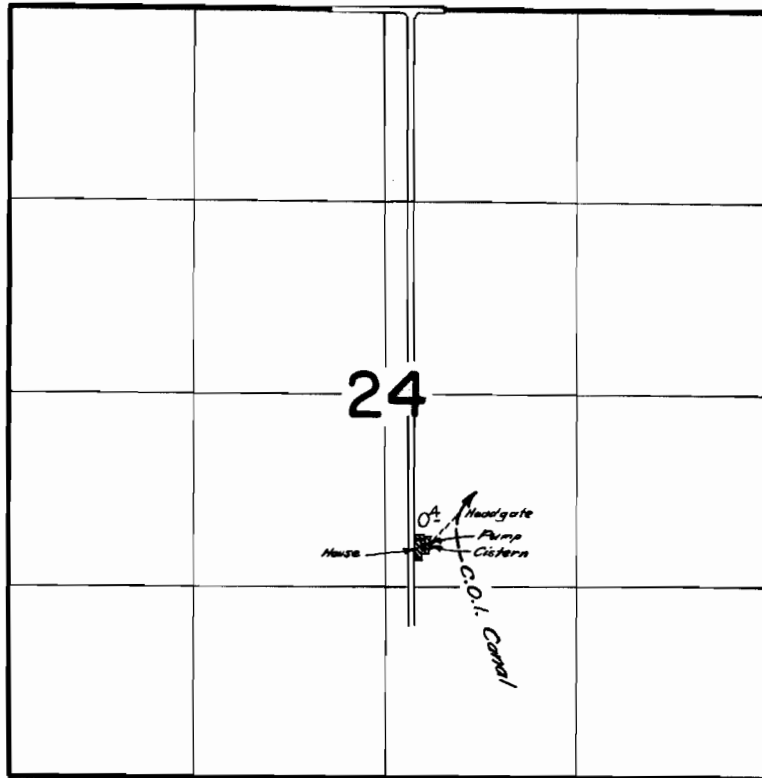

**FINAL PROOF SURVEY**  
UNDER

Transfer No. C-131


Application No. \_\_\_\_\_ Permit No. \_\_\_\_\_

IN NAME OF

**ELMER STAMPER**

Surveyed *August 28 1905*, by *A. Jackson*

T.15S.R.13E.W.M.

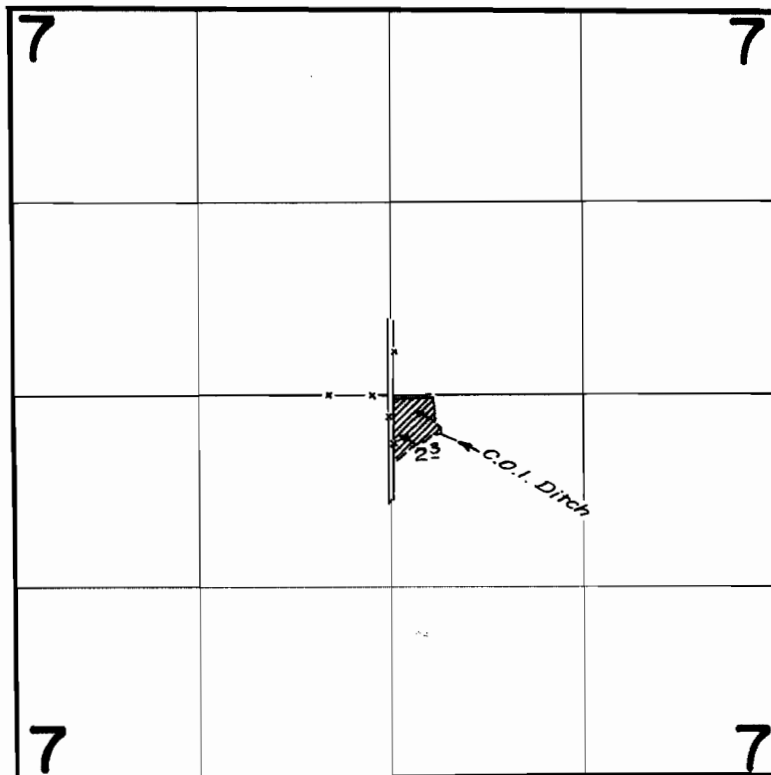

**FINAL PROOF SURVEY**  
UNDER


**Transfer No. C-131**

Application No. .... Permit No. ....  
IN NAME OF

**PRIDAY HOLMES**

Surveyed *August 25 1965*, by *L. Jackson*

T.14S.R.13E.W.M.

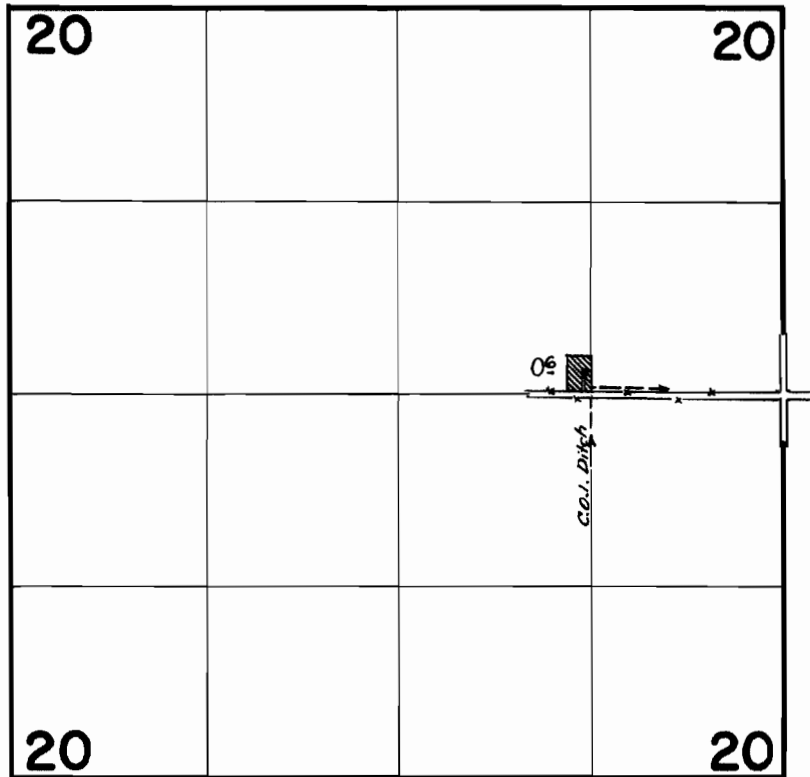

**FINAL PROOF SURVEY**  
UNDER


Transfer No. C-131

Application No. .... Permit No. ....  
IN NAME OF

**DELMER WAGNER**

Surveyed *August 30 1965*, by *R. Jackson*

T.17S.R.12E.W.M.

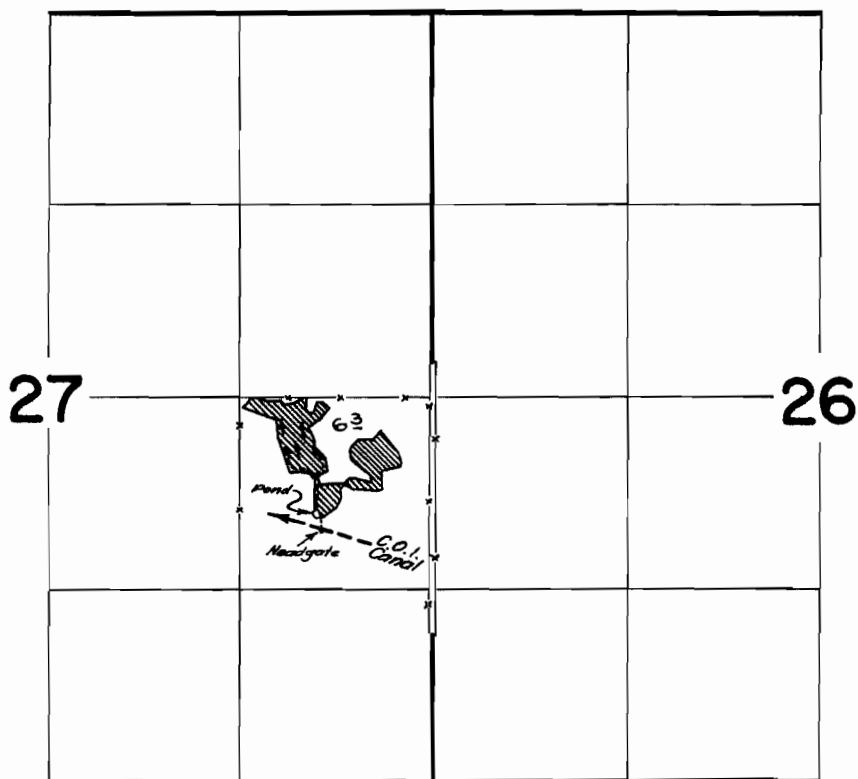

**FINAL PROOF SURVEY**  
UNDER

Transfer No. C-131

Application No. \_\_\_\_\_ Permit No. \_\_\_\_\_

IN NAME OF

**D. O. CONNER**

Surveyed *August 13* 1965, by *A. Jackson*