


T. I. S. R. 13 E. W.M. .

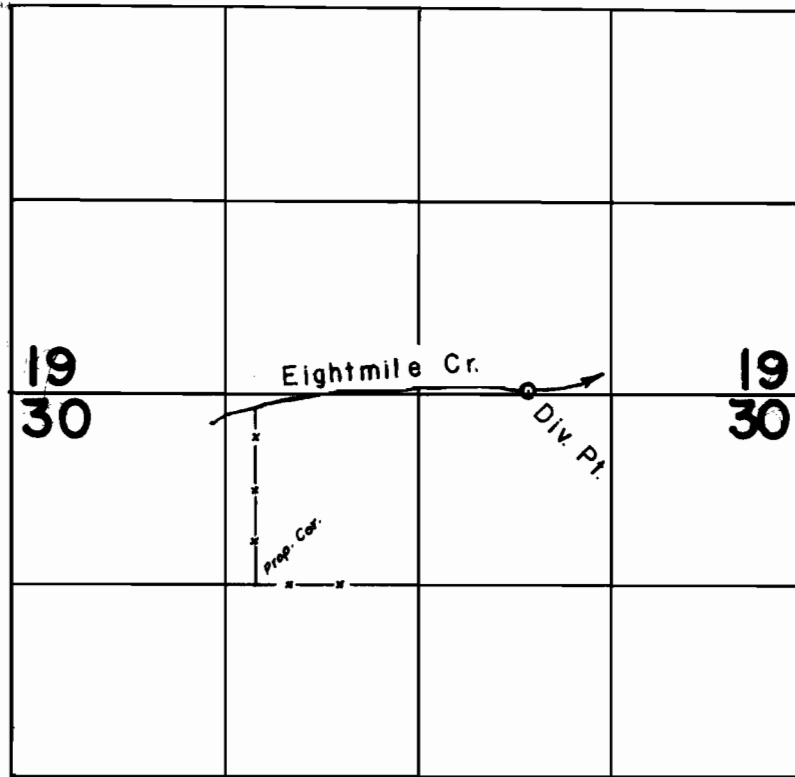

FINAL PROOF SURVEY
UNDER

Transfer No. C-134
IN NAME OF

F. W. CAROTHERS

Surveyed April 11, 1962, by L. W. Jelouck

