


T. 1 S. R. 13 E. W.M.

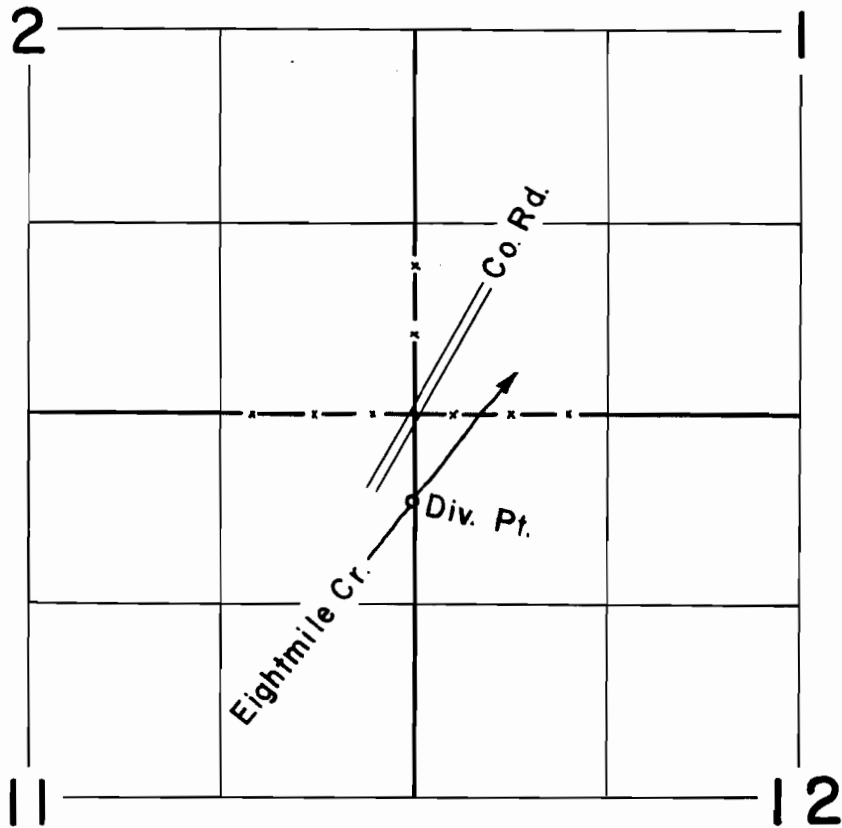

FINAL PROOF SURVEY
UNDER

Transfer No. C-135
IN NAME OF

CLAIR CREIGHTON

Surveyed Dec. 12, 1962, by *L. W. Jelousch*