


TOWNSHIP 34 S, RANGE 1 W, W. M.

RECEIVED
FEB 8 1962
STATE ENGINEER
SALEM, OREGON

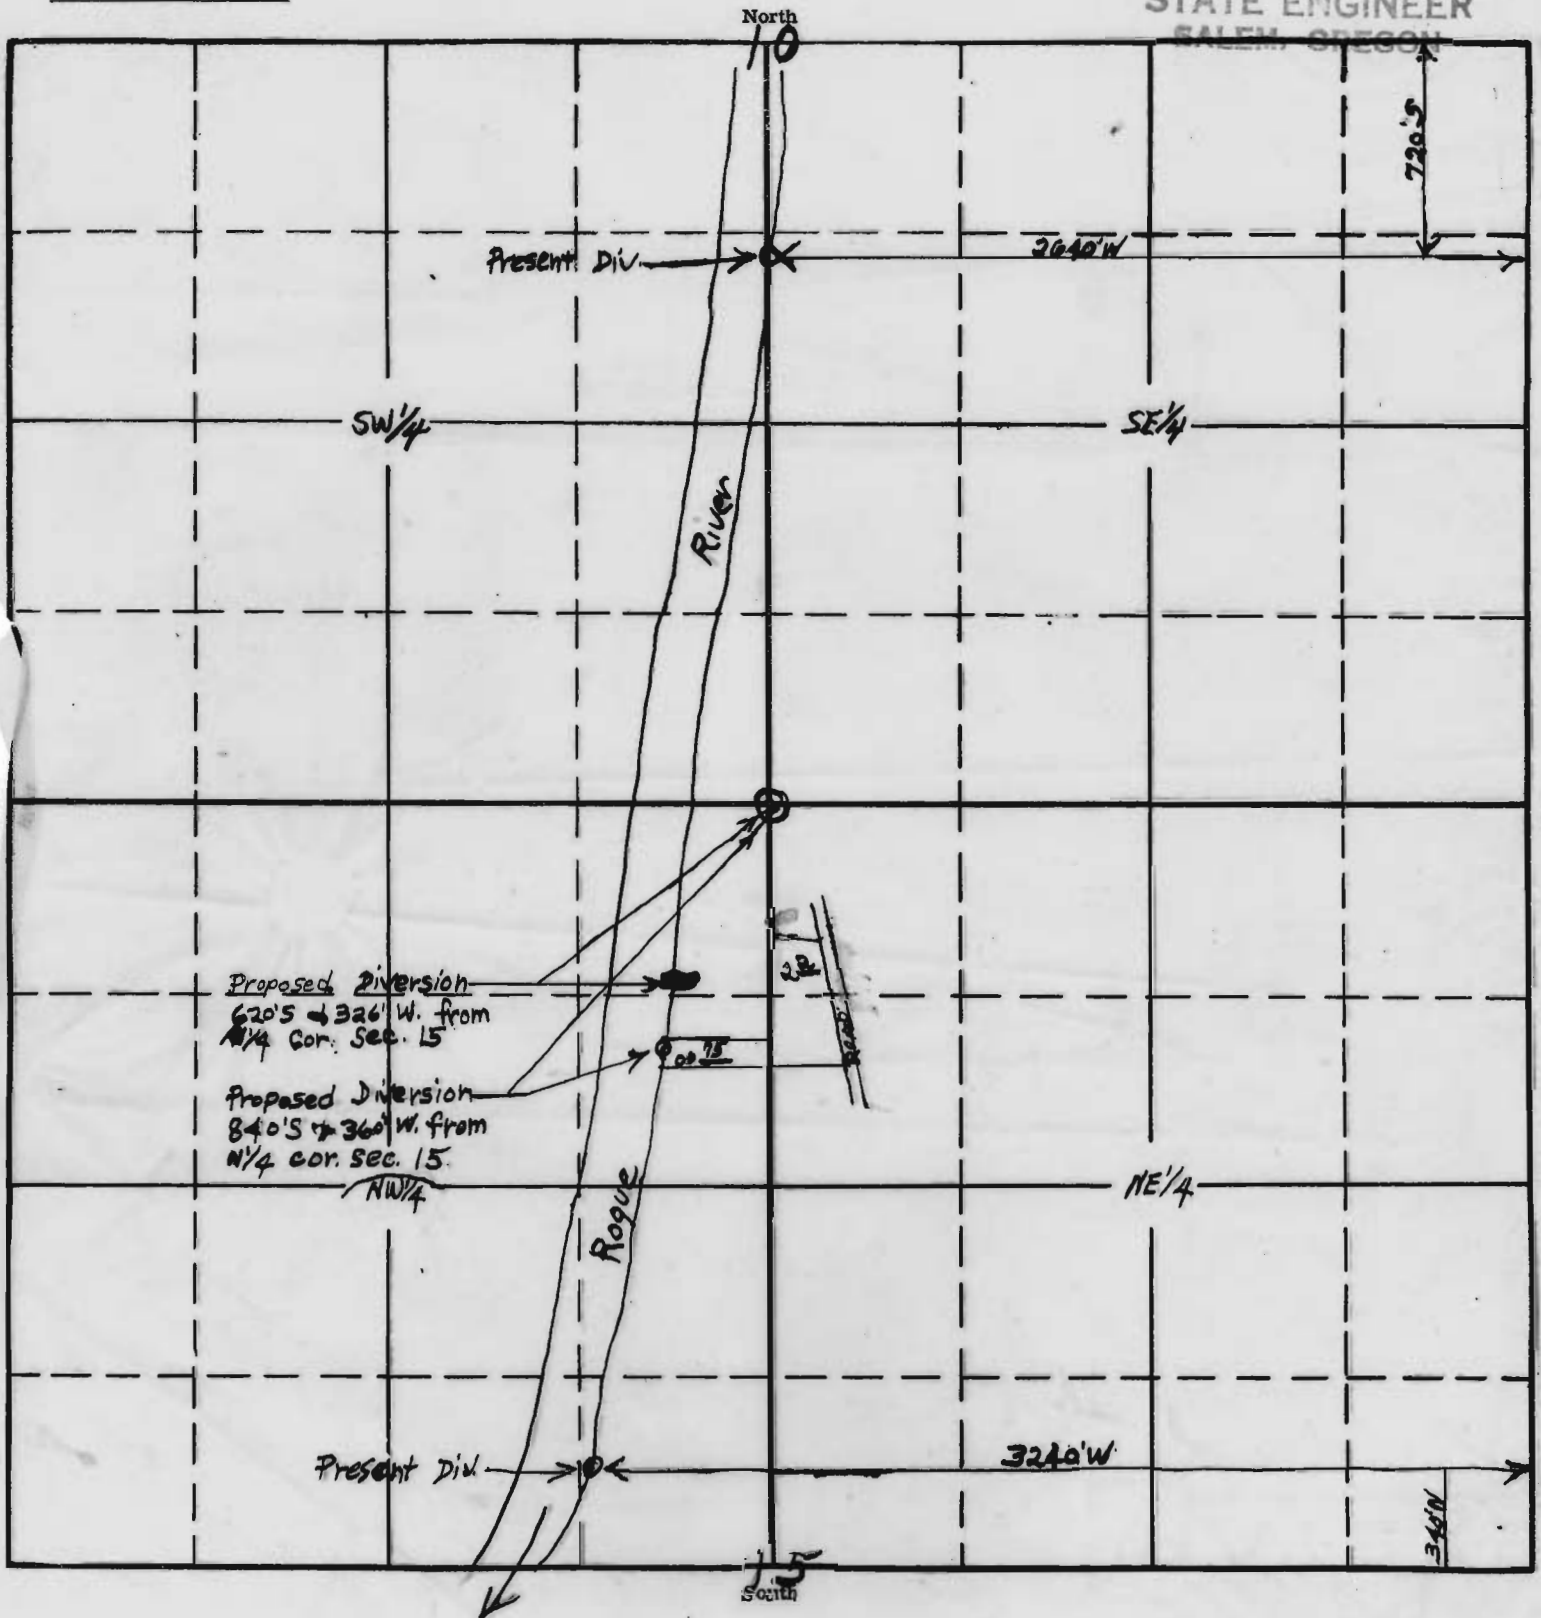

(Scale) 8" = 1 mile

APPLICATION No.
PERMIT No.