


Note D-6382
PARALLELS CLARK CREEK
USED MAP #58780 NE 1/4 SW 1/4

T.IN.R.39E.W.M.

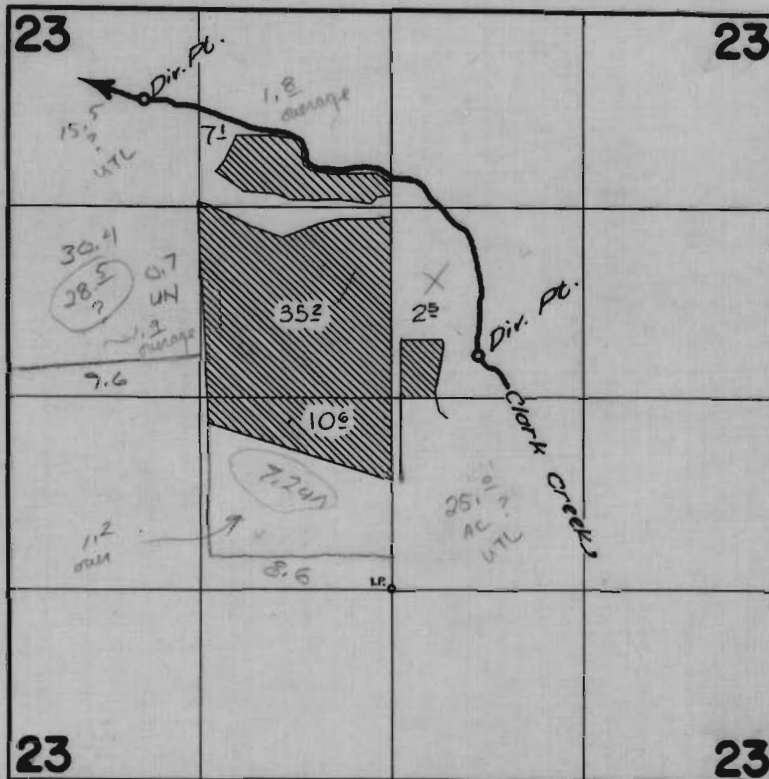

FINAL PROOF SURVEY UNDER

Transfer No. C-140

Application No. Permit No.

IN NAME OF

LAVON CULVER

Surveyed Sept. 24 1963, by J. Lauer

Vol. 12, P. 58