


T. 13 S.R. 34 E.W.M.

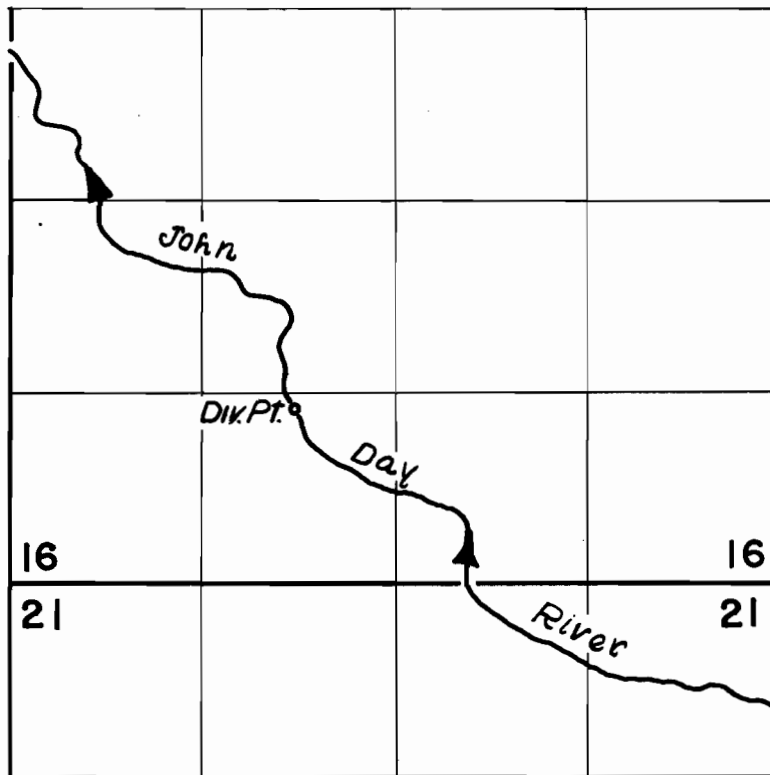

FINAL PROOF SURVEY
UNDER

Transfer No. C-141
Application No. Permit No.

IN NAME OF

.....**ROBERT L. CARTER**.....

Surveyed *Nov. 10, 1962*, by *C. R. Baker*.....