


T.17S.R.12E.W.M.

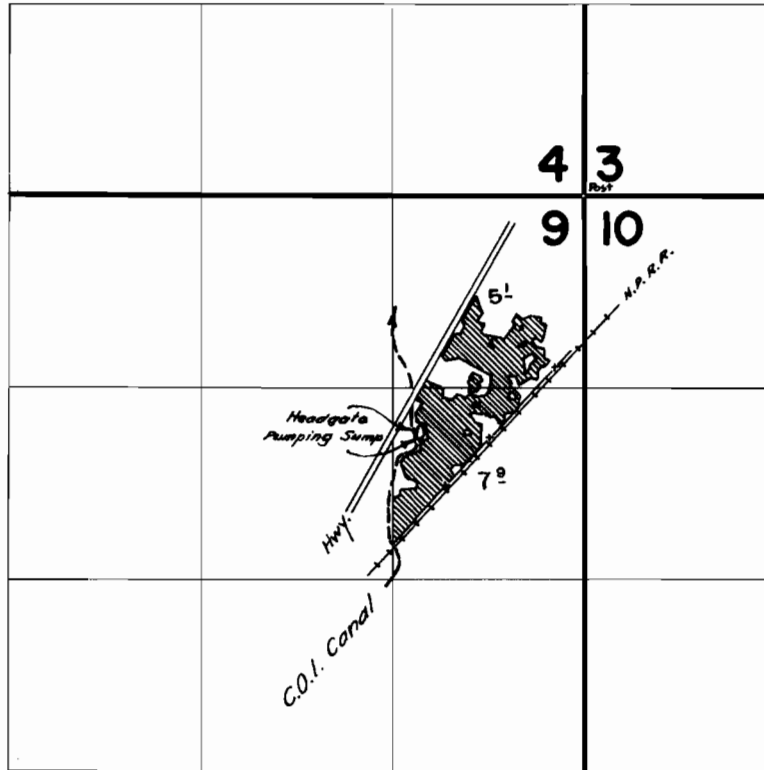

FINAL PROOF SURVEY
UNDER

Transfer No. C-151

Application No. _____ Permit No. _____
IN NAME OF

REUBEN D. SCHOTT

Surveyed August 12, 1965, by *R. Johnson*