


T.16S.R.12E.W.M.

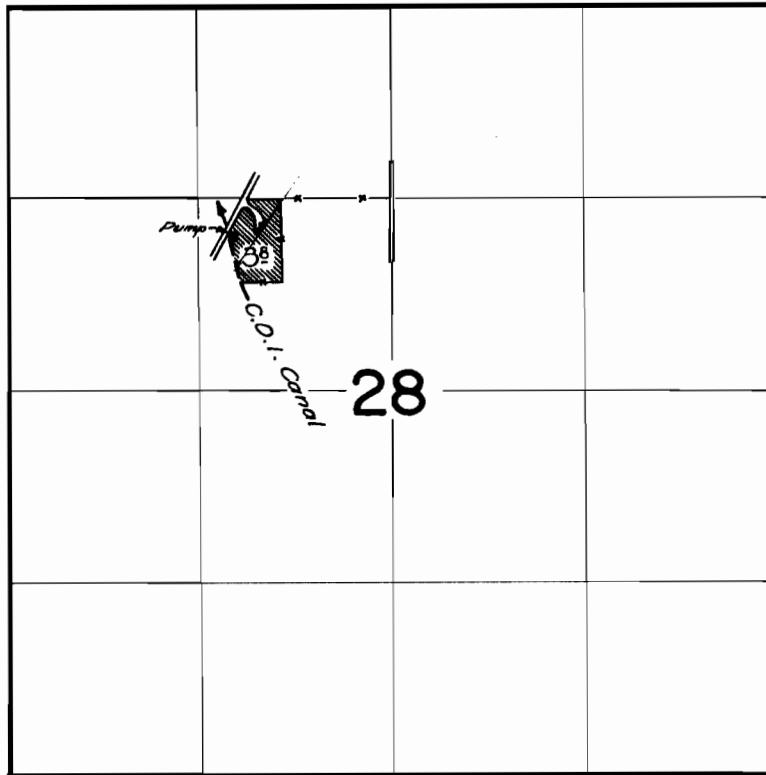

FINAL PROOF SURVEY
UNDER

Transfer No. C-155

Application No. _____ Permit No. _____

IN NAME OF

JAMES S. FRAKES

Surveyed August 9, 1965, by *R. Jackson*