


T.39S. R.1W. W.M

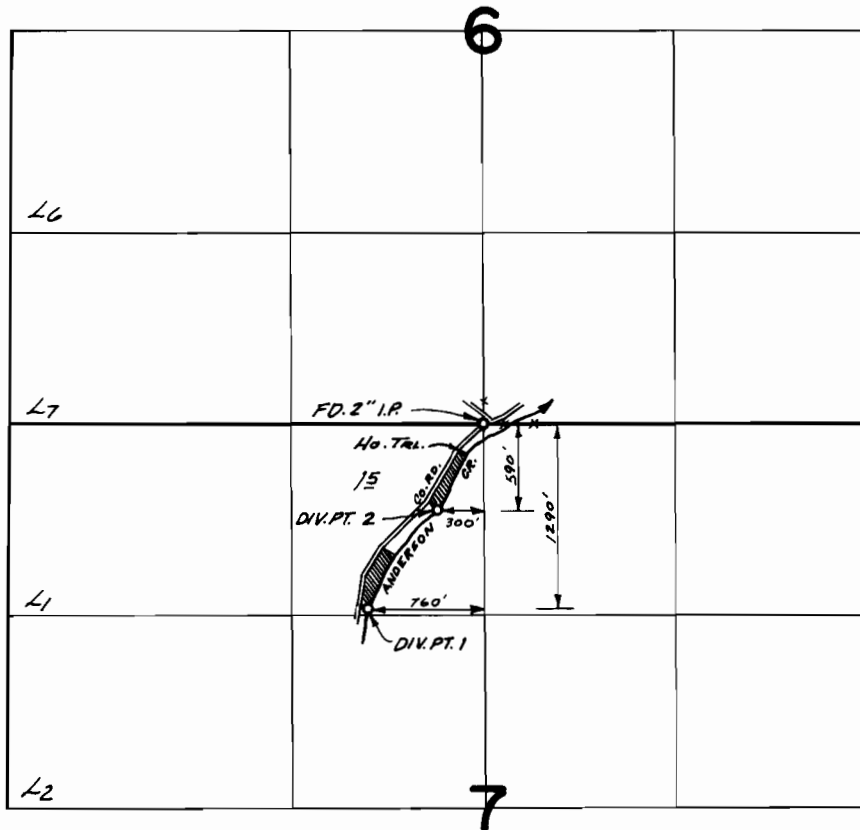

FINAL PROOF SURVEY UNDER

TRANSFER NO. C159
Application No. Permit No.
IN NAME OF

..... RICHARD J. STANEK

Surveyed July 16, 1974, by L.M. TOLL.....