


T. 4 & 5 S. R. 3 E. W. M.

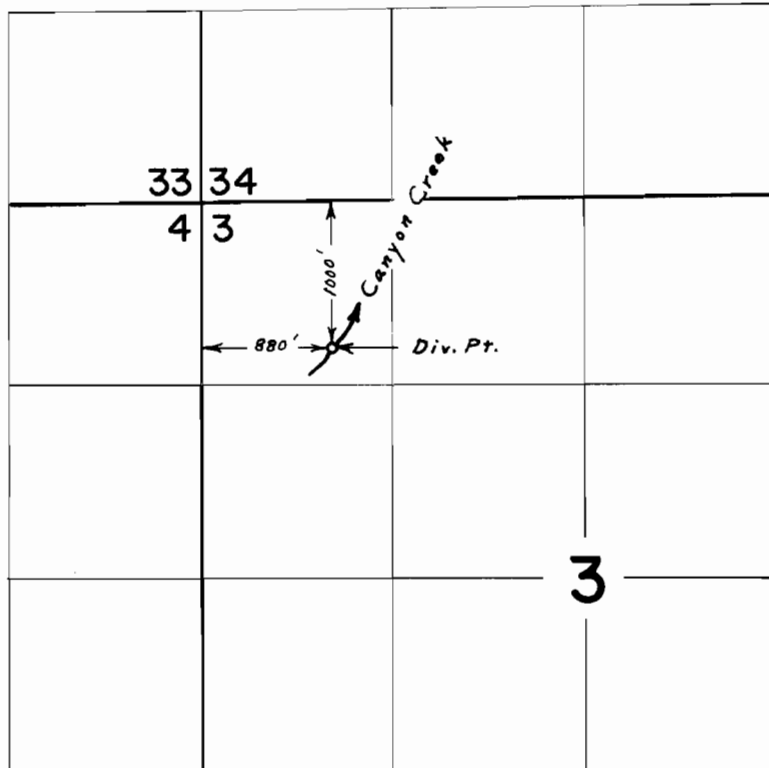

FINAL PROOF SURVEY UNDER

Application No. _____ TRANSFER C-167
Permit No. _____
IN NAME OF
COLTON SCHOOL DISTRICT NO. 53
Surveyed Nov. 19, 1969, by L. E. Gould