


T.16S. R.14E. W.M.

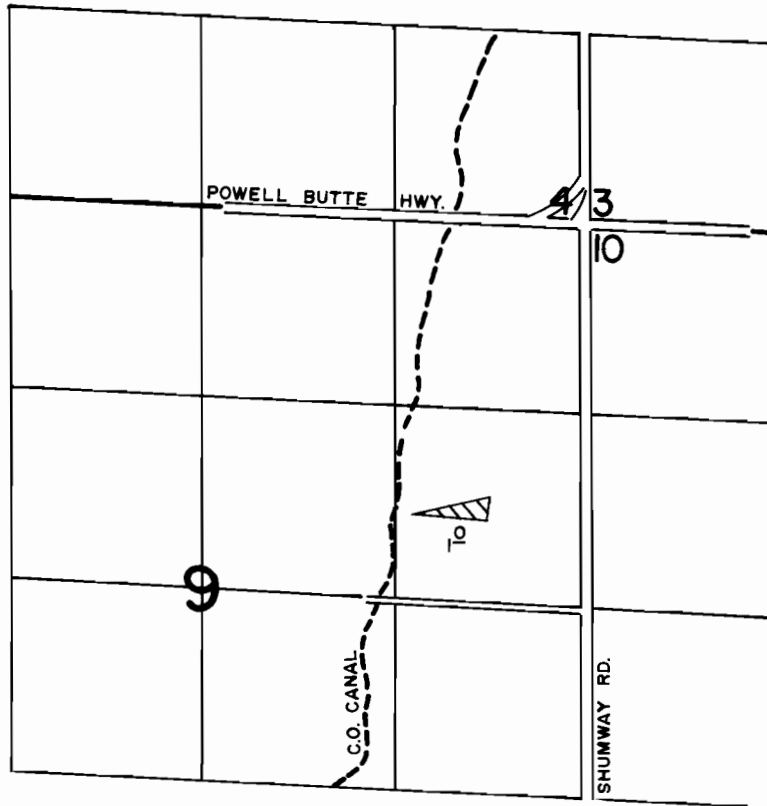

FOR ADJACENT RIGHTS SEE Trs. 3174 & 3459

FINAL PROOF SURVEY UNDER

PORTION OF TRANSFER C-169

Application No. Permit No.
IN NAME OF

..... **ROBERT W. McCASLAND**

Surveyed **MAY 27**... 1980., by **L.H. NUNN**.....