
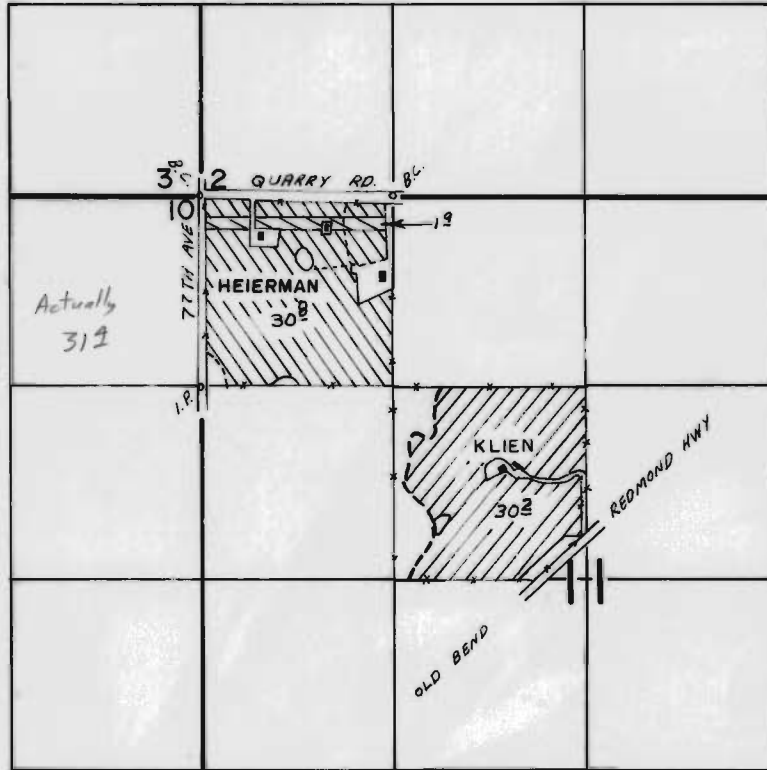
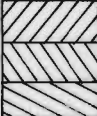



T.16S. R.12E. W.M.

 

 KLEIN PORTION C-170
 HEIERMAN PORTION C-170
 3463

FINAL PROOF SURVEY
UNDER

TRANSFER NO. C-170
3463

Application No. Permit No.
IN NAME OF

.... DAN. H. HEIERMAN, SR. & ORVAL KLEIN ...

Surveyed APR. 4, 8. 1980., by L.H. NUNN.....