


T. 36 S. R. 1 W. W. M.

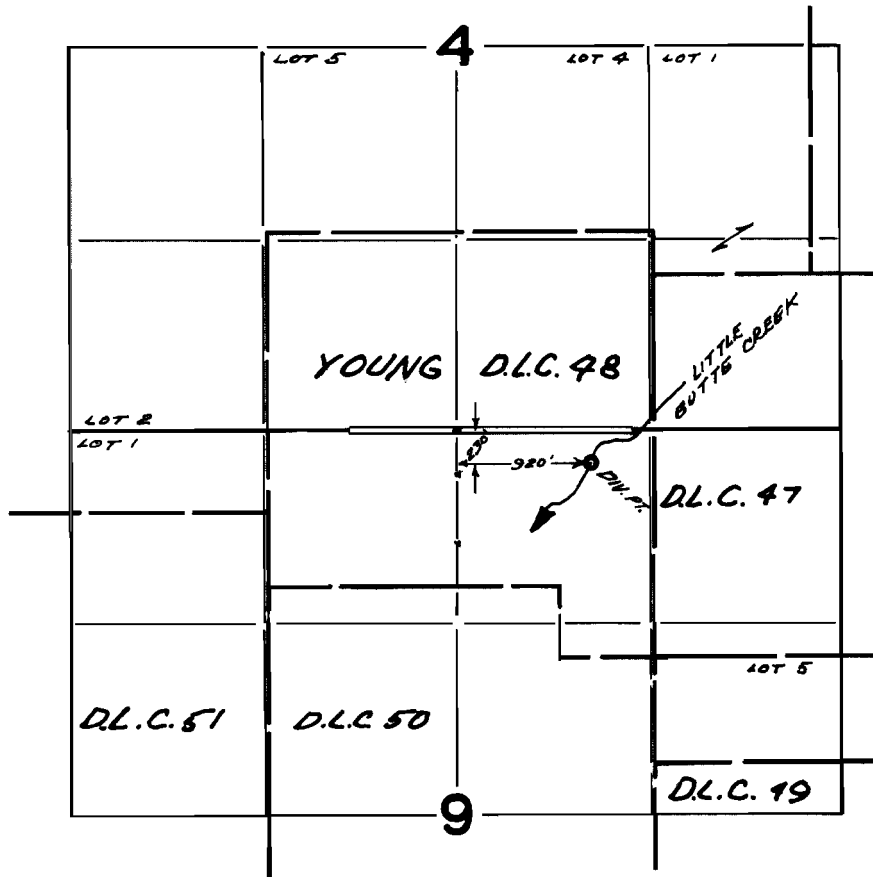

FINAL PROOF SURVEY
UNDER

TRANSFER No. C-171
Application No. Permit No.
IN NAME OF

..... *DOROTHY CHARLEY*

Surveyed *JUN. 5* 19*68*, by *V. GARNER*