


T. 36S.R. 2E.W.M.

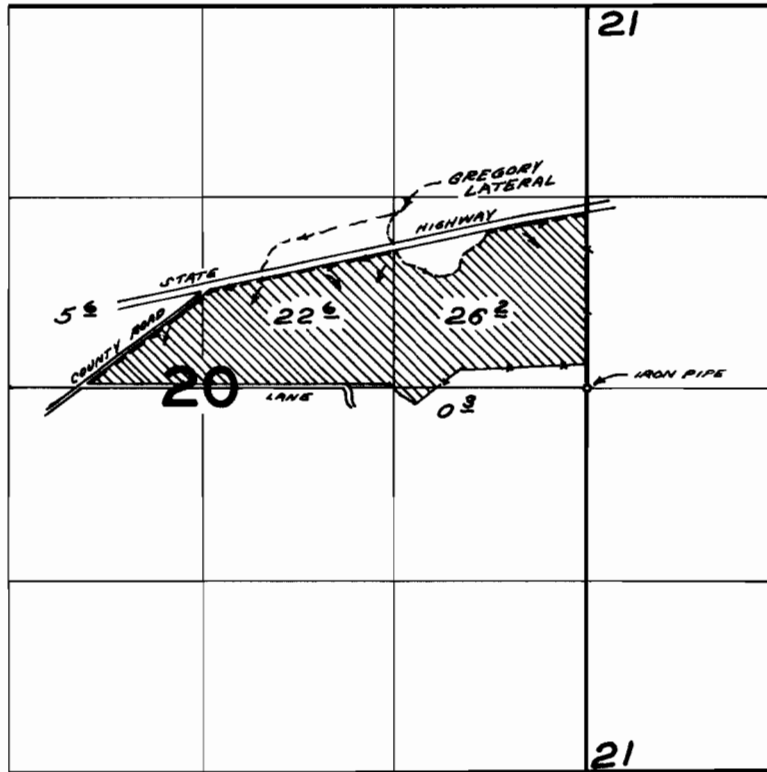

FINAL PROOF SURVEY
UNDER

TRANSFER No. C-172
Application No. Permit No.
IN NAME OF

JAMES F. AND LURLINE R. COONAN

Surveyed *JUN 10* 1968, by *V. GARNER*