


T.7S. R.38E. W.M.

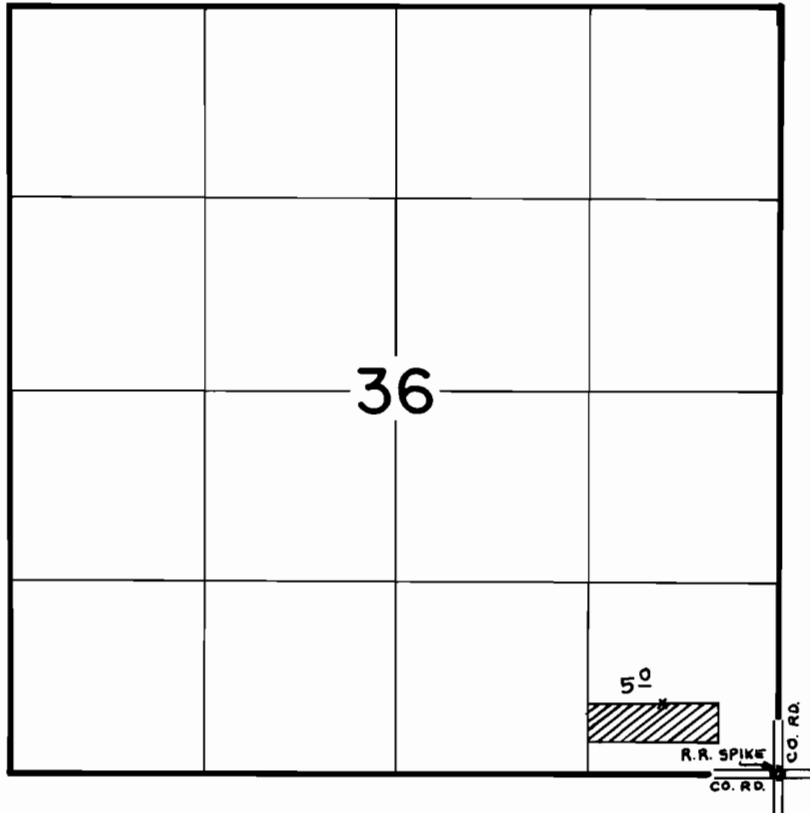

FINAL PROOF SURVEY
UNDER

Transfer No. C-174
Application No. Permit No.

IN NAME OF

..... DONALD WILLIAM CHRISTY

Surveyed JUL 4, 1970, by L.E GOULD