


T. 36 S., R. 1 E., W. M.
T. 36 S., R. 1 W., W. M.

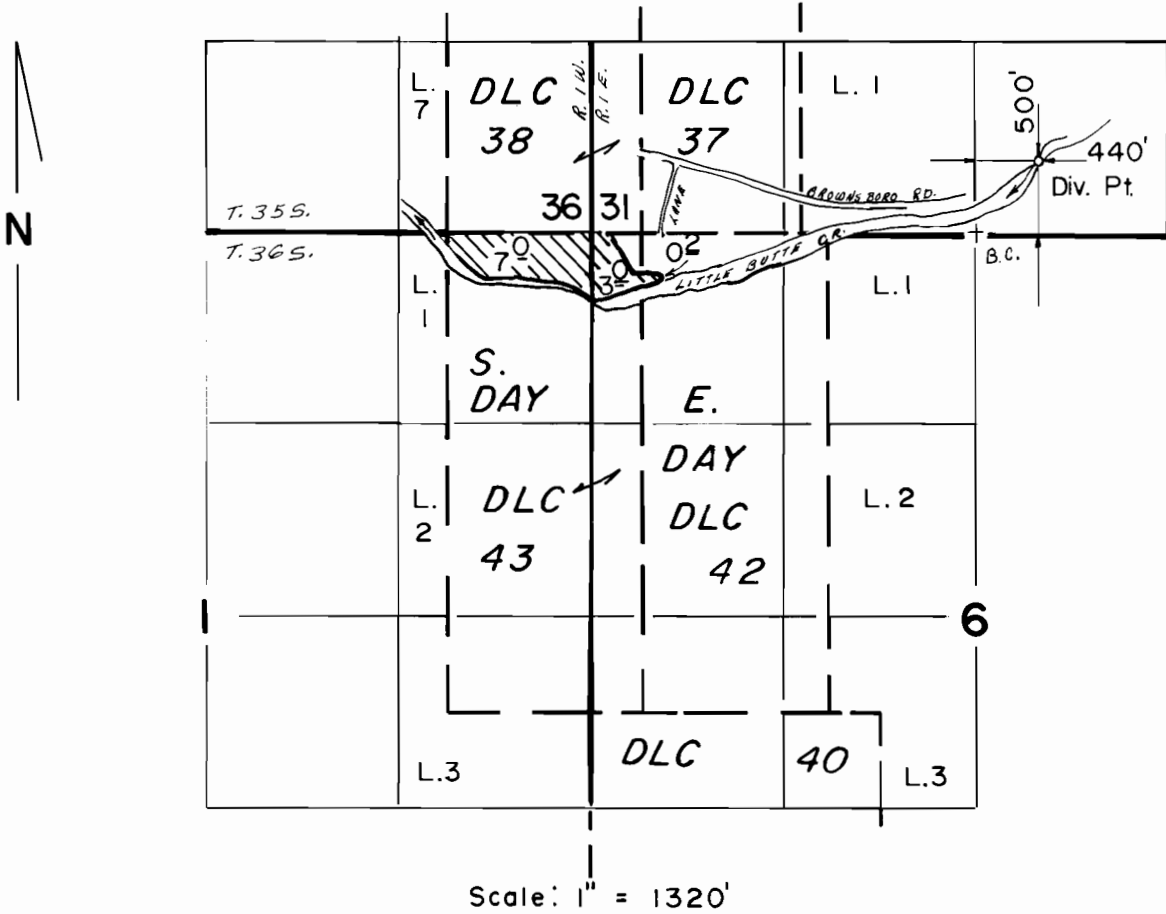

FINAL PROOF SURVEY
UNDER

TRANSFER NO. C-177

Application No. Permit No.
IN NAME OF

..... **RON BJORK**

Surveyed F.E.B., 8., 1988, by B.S. JAMES....