


T.36 S., R.2 E., W.M.

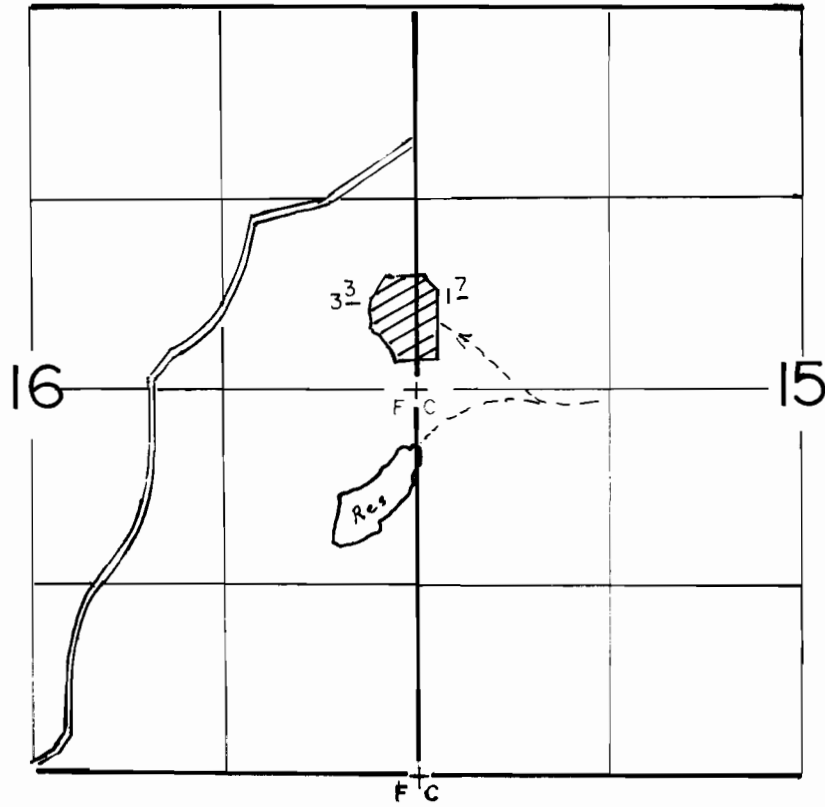

SCALE: 1" = 1320'

FINAL PROOF SURVEY
UNDER

TRANSFER NO. C-191

Application No. Permit No.
IN NAME OF

JAMES F. & LURLINE COONAN.....

Surveyed JUNE 7, 1989., by B.S. JAMES.....