


T.39S.R.2E.W.M.

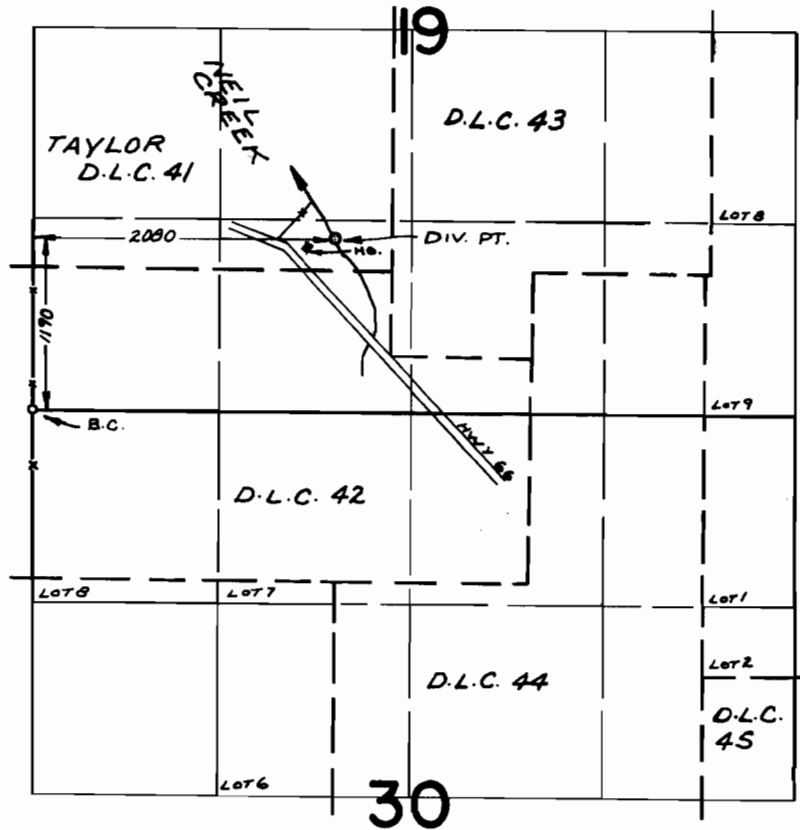

FINAL PROOF SURVEY UNDER

TRANSFER NO. C-200

Application No. Permit No.

IN NAME OF

ORVILLE R. & MIGNON L. CAUGHRAN & AMA TAYLOR

Surveyed SEPT 18 1914., by R. MUCKEN.