
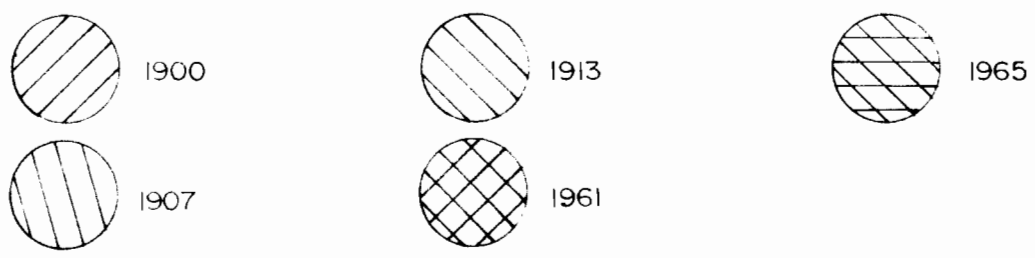


SECTION 35 T.16 S. R.11 E. W.M.

1" = 400'

"10" MAP FOR C-180

3.8 OFF
2.3 ON
1.0 ON
1.0 ON
1.5 OFF

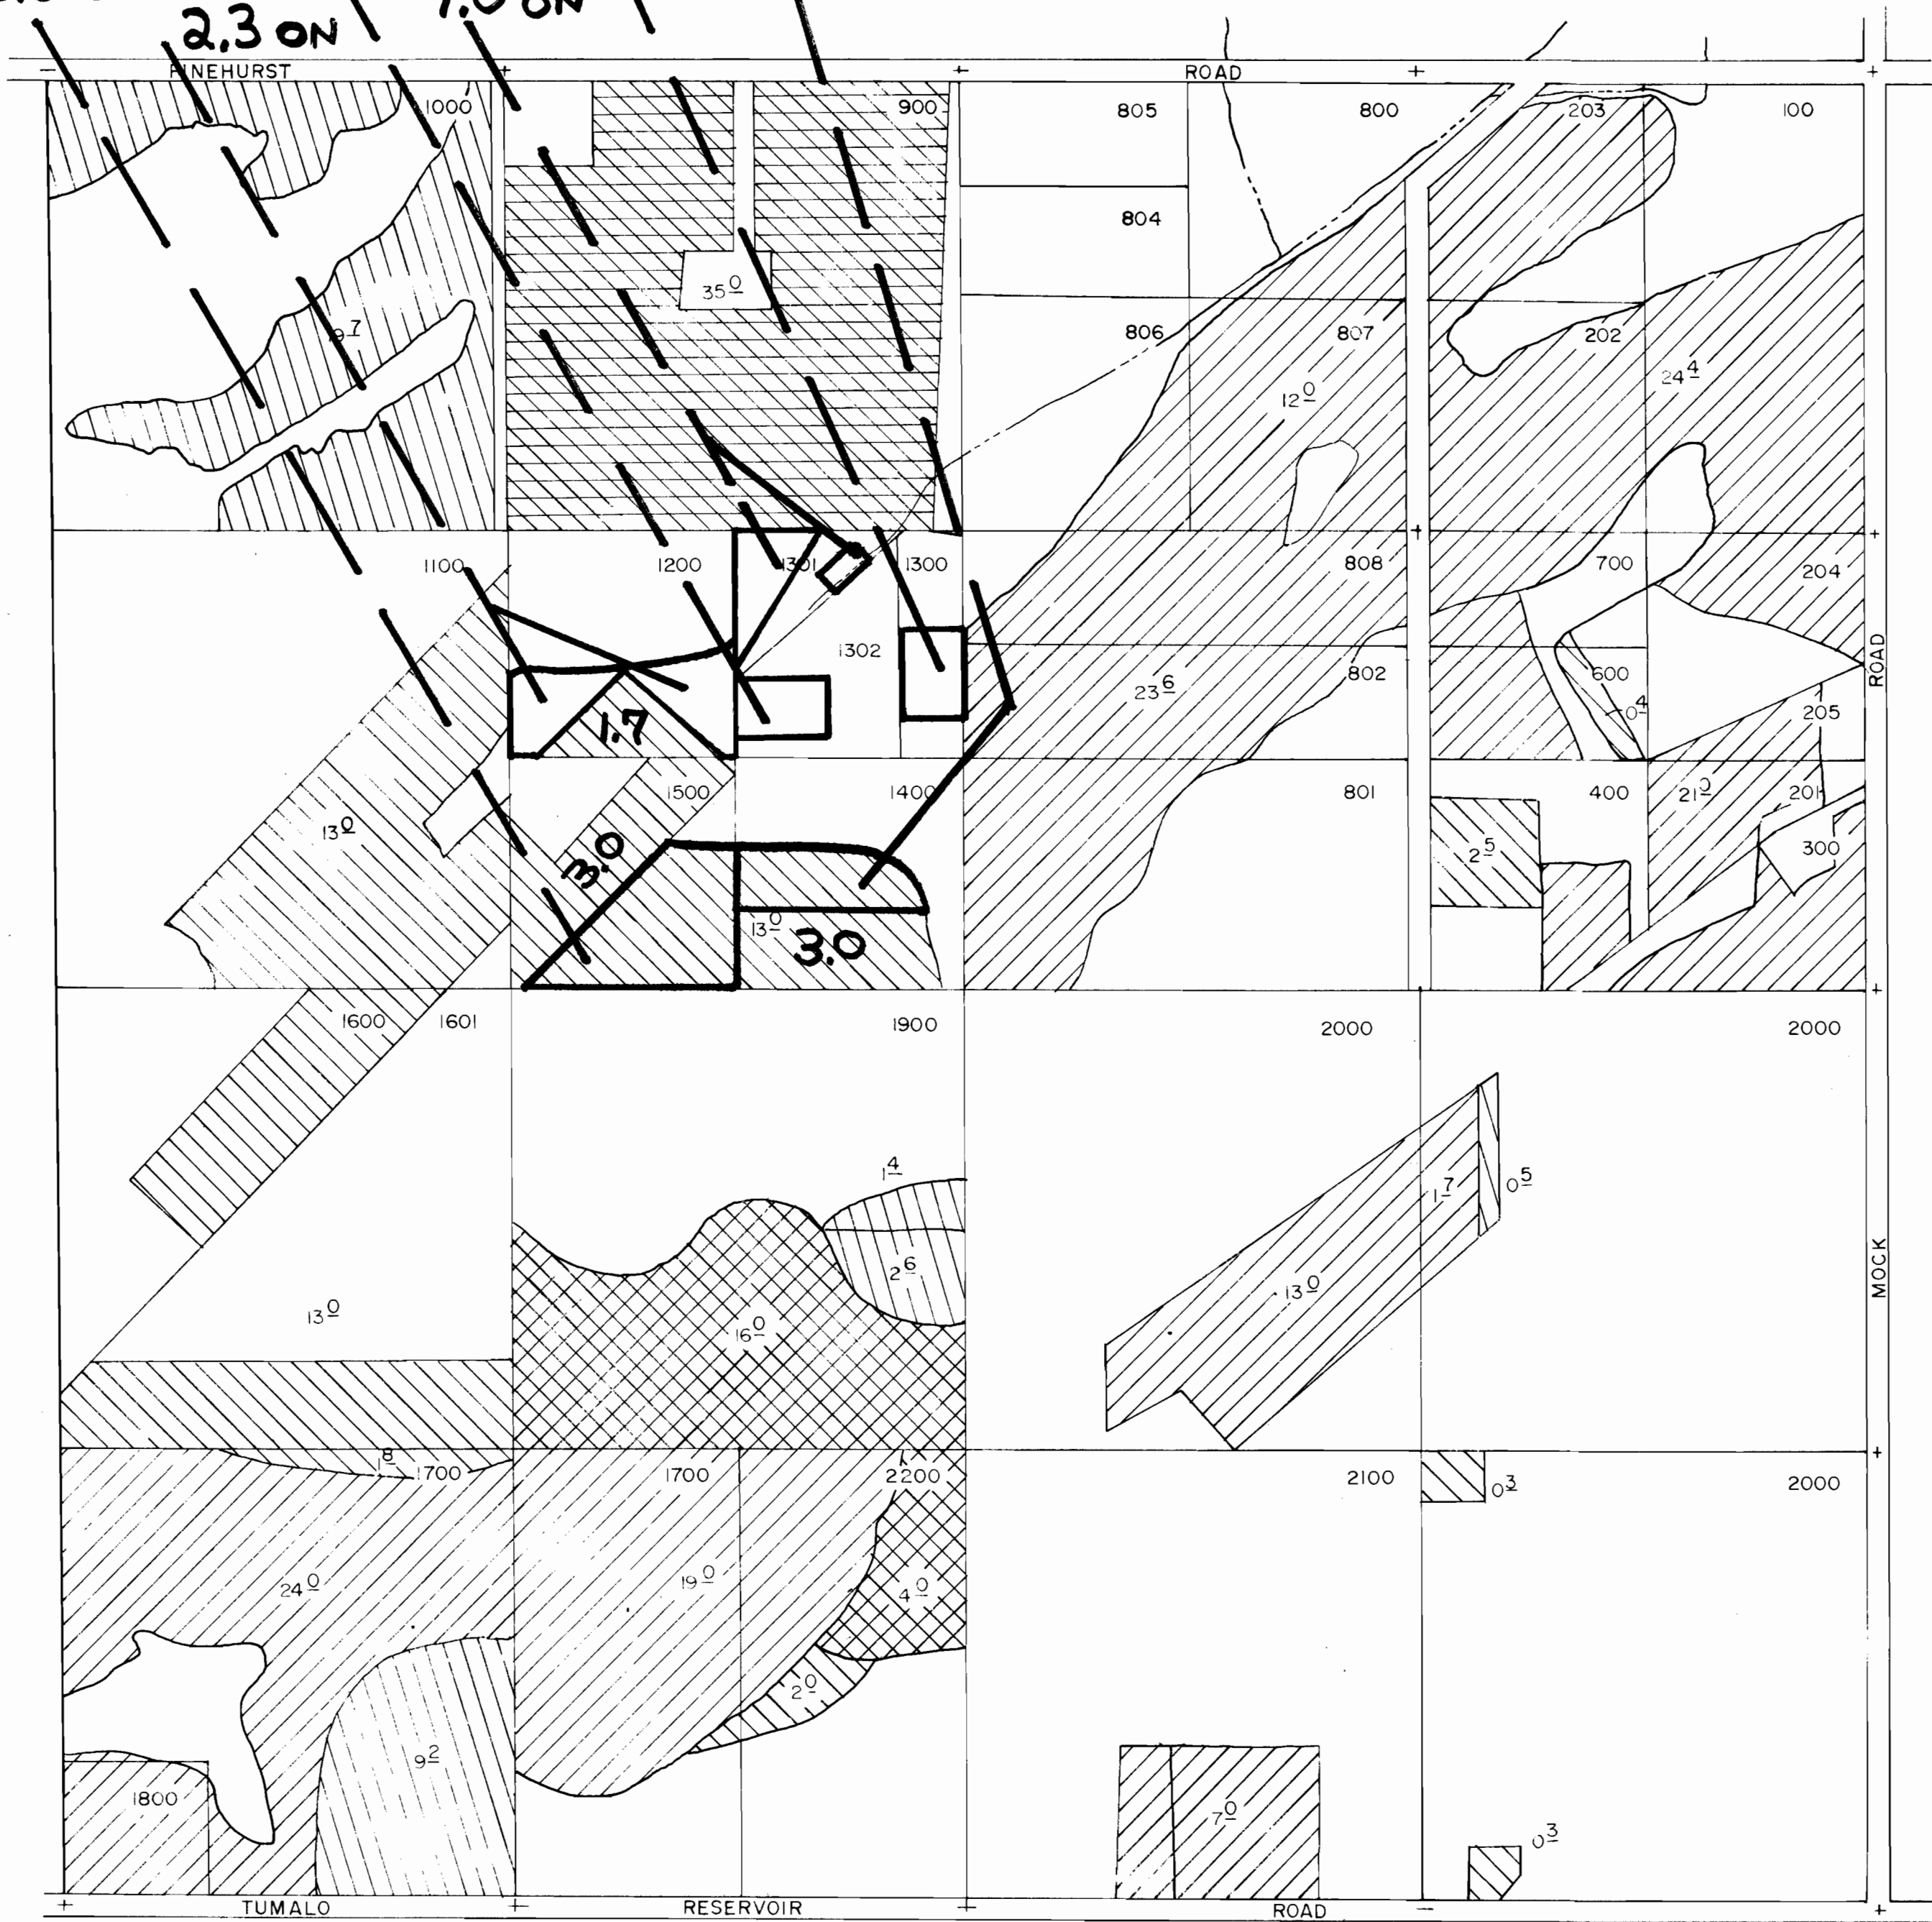

RECEIVED
APR 18 1962
WATER RESOURCES DEPT
SALEM, OREGON