


SECTION

TOWNSHIP 65, RANGE 38 E, W. M.

North

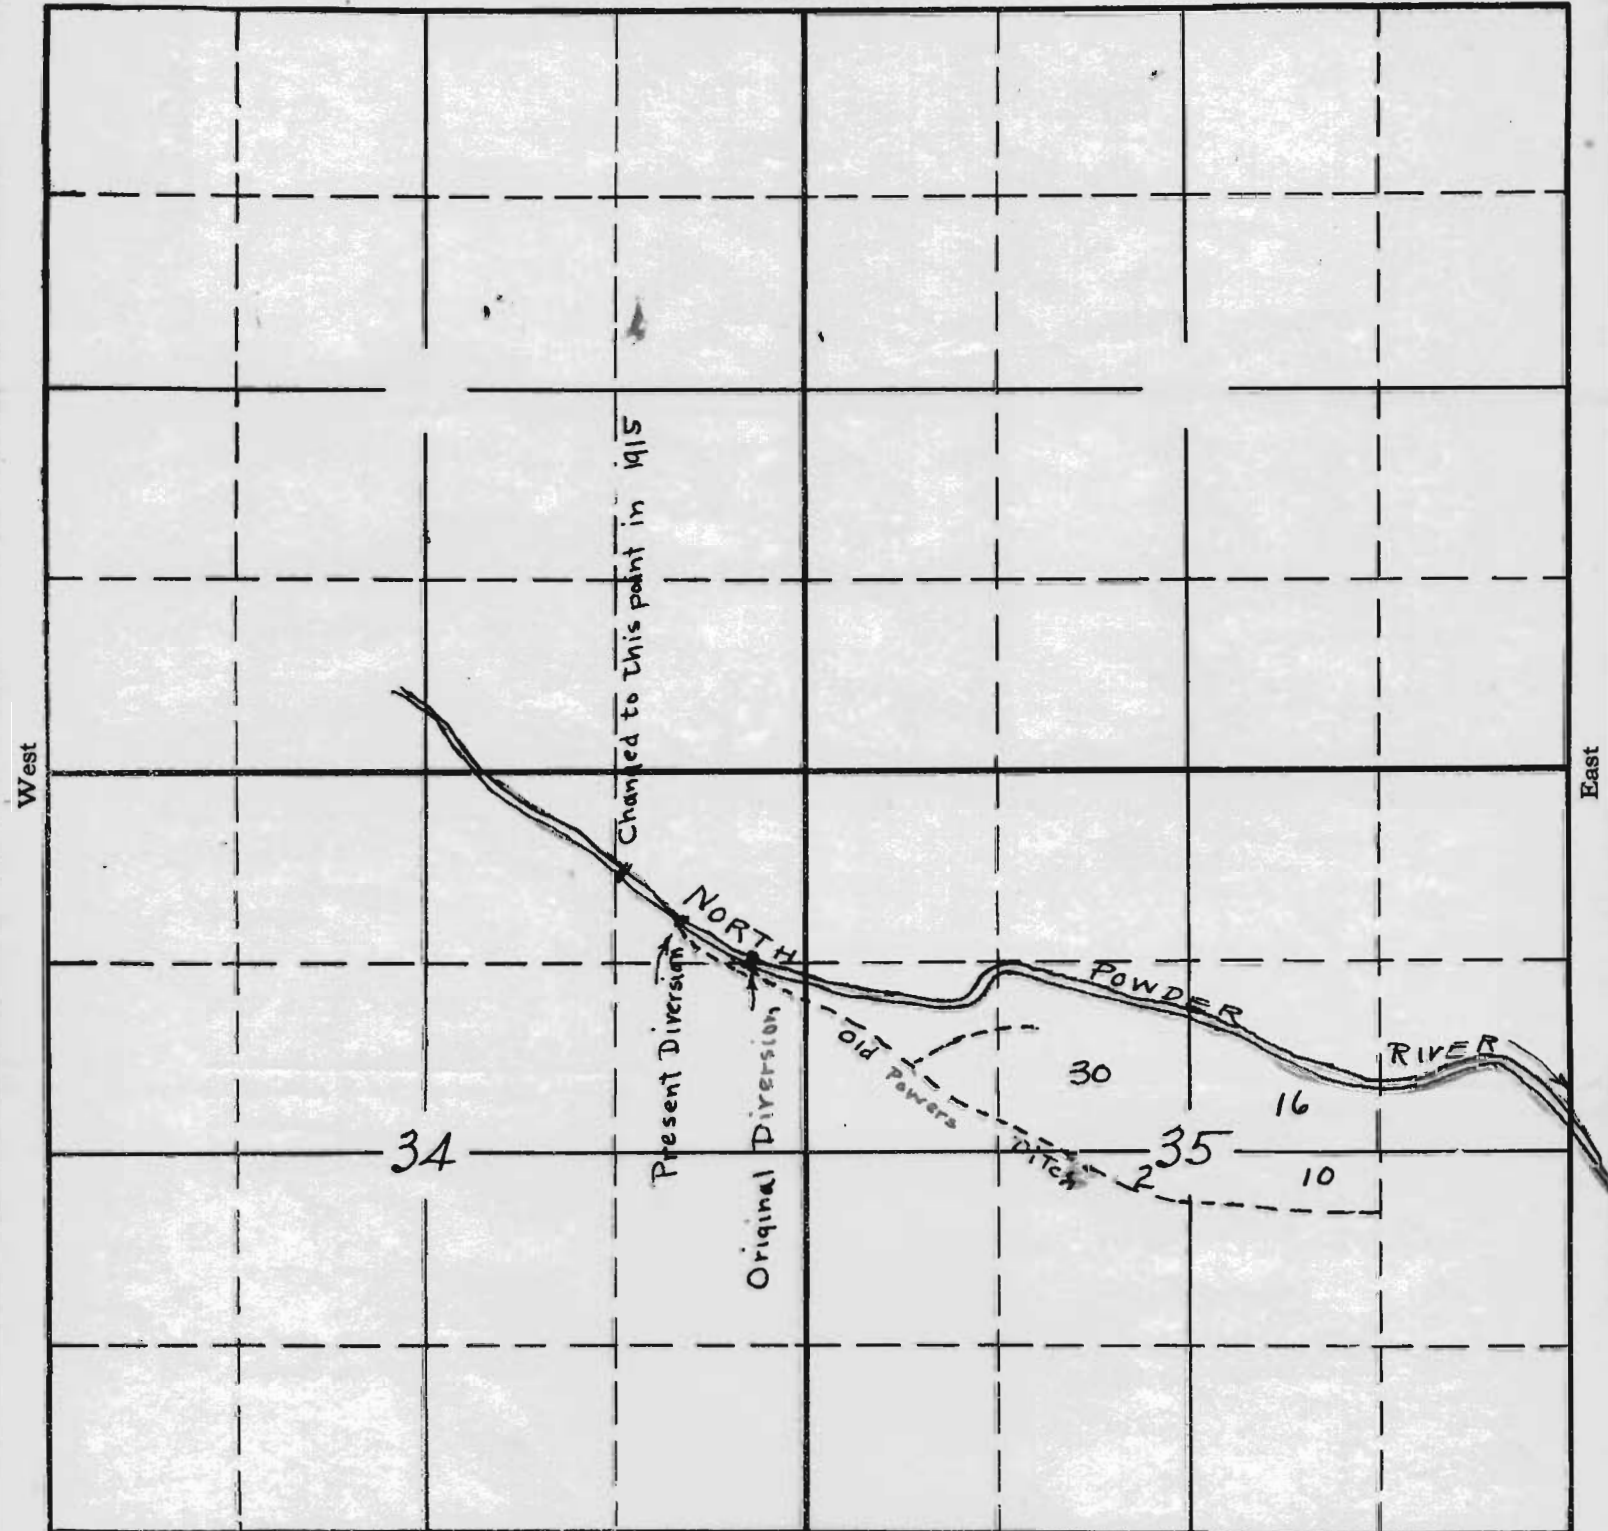

South

APPLICATION No.

PERMIT No.