


T. 3 S. R. 7 E. W. M.

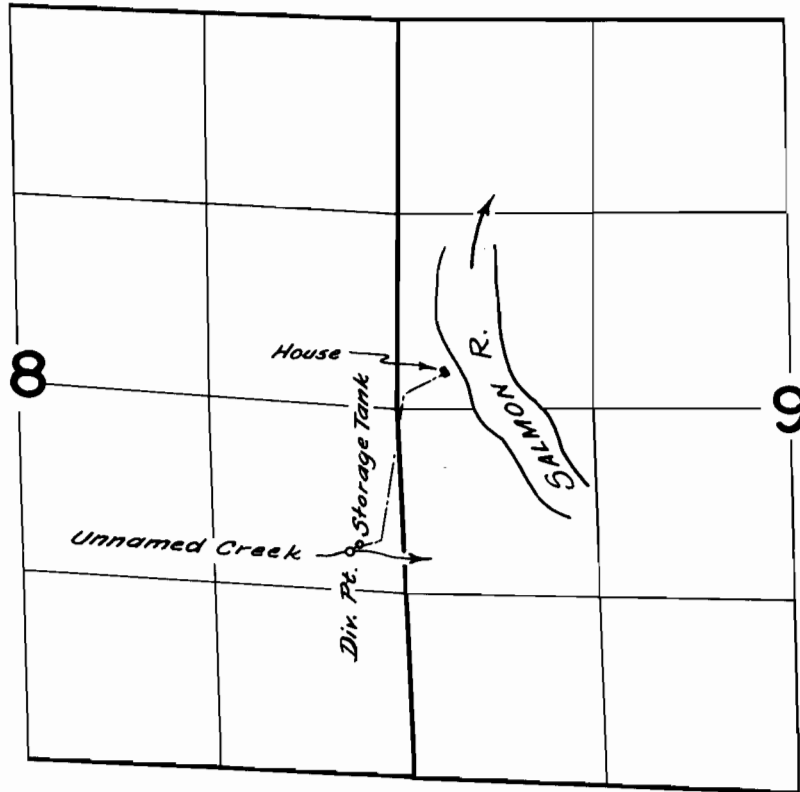

FINAL PROOF SURVEY
UNDER

Transfer # D-9
Application No. _____ Permit No. _____
IN NAME OF

..... *Ed. & Millie Steubs*

Surveyed *July 26 1961*, by *C. O. Barsto*.